

Marion

E 10

3-69

MISSISSIPPI  
 BOARD OF WATER COMMISSIONERS  
 416 North State Street  
 Jackson, Mississippi 39201

CODED  
CODED

WATER WELL DRILLERS LOG

3-4th 1969 Dean Krines Marion  
 date well completed firm name county well located

LANDOWNER:  
Pat Sault  
Route 1 Popworth  
Miss. (mailing address)

description of formations encountered	from	to
top soil	0	1'
chalk	1	20'
fine sand	20	40'
sand & rocks	40	80'
water sand	80	112'

WELL LOCATION:  
 sec 3 T 4 N R 20 E  
 S 12 miles N W of Columbia  
 (distance) (direction) (nearest town)

WELL PURPOSE: Home sale  
 (home, irrigation, municipal, industrial)

WELL COMPLETION DATA:

(1) diameter (inches) 3"

(2) total depth (feet) 112

(3) static water level (feet) \_\_\_\_\_ below  
 top of ground. above

(4) casing Plastic, 104  
 (material) (depth)

\_\_\_\_\_ if telescope see back.  
 (size)

(5) screen 8", 102  
 (length) (depth to top)

2", S.S. Strainer  
 (size) (material)

(6) pump 1 \_\_\_\_\_  
 (HP) (yield gpm)

Jet Pump  
 (type power)

(7) electric log \_\_\_\_\_  
 (yes or no)

\_\_\_\_\_ (organization running log)

(8) how well bottom plugged \_\_\_\_\_

CODED CODED


MAR 10 1969

DRILLERS REMARKS:

MISS. DE. OF  
 WATER PER. OF  
 MISS. COM. OF  
 WATER CONTROL

If well telescopes please sketch and show depths.

GROUND LEVEL

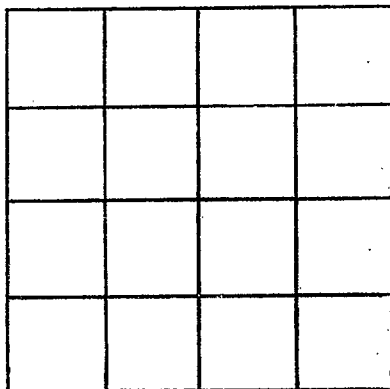

SECTION \_\_\_\_\_

Please indicate well location X.

ADDITIONAL INFORMATION

If more than one screen, show locations of each on sketch.