

MISSISSIPPI
BOARD OF WATER COMMISSIONERS
416 North State Street
Jackson, Mississippi 39201

CODED

WATER WELL DRILLERS LOG

Marion
E 11
7-68

7-16 1968 Rogant & Fiel Marion
date well completed firm name county well located

LANDOWNER: Dalton Bracy
Rt. 1 Kabama, Missis
(mailing address)

description of formations encountered	from	to
<u>Clay + gravel</u>	<u>0</u>	<u>101</u>
<u>pear gravel</u>	<u>101</u>	<u>142</u>


WELL LOCATION:
sec. 23 T 4 N R. 12 E
S W
11 miles N of Kabama
(distance) (direction) (nearest town)

WELL PURPOSE: home
(home) Irrigation, municipal, industrial)

- WELL COMPLETION DATA:
- (1) diameter (inches) 4"
- (2) total depth (feet) 142'
- (3) static water level (feet) 41' below above
top of ground.
- (4) casing plast. 134'
(material) (depth)
 if telescope see back.
(size)
- (5) screen 8' 134'
(length) (depth to top)
.008 plast.
(size) (material)
- (6) pump 3/4
(HP) (yield gpm)
elect
(type power)
- (7) electric log no
(yes or no)

(organization running log)
- (8) how well bottom plugged Back
wash valve


CODED

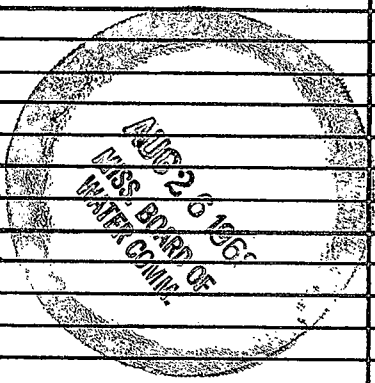

DRILLERS REMARKS: _____

If well telescopes please
sketch and show depths.

GROUND LEVEL

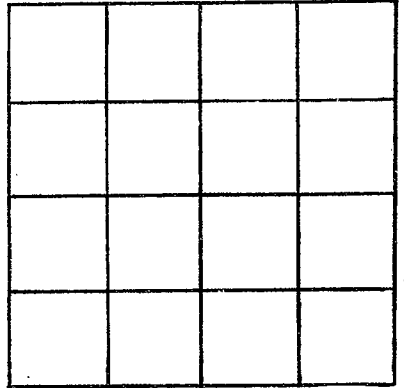

SECTION _____

Please indicate well location X.

ADDITIONAL INFORMATION

If more than one screen,
show locations of each on sketch.