

CODED

MISSISSIPPI
BOARD OF WATER COMMISSIONERS
416 North State Street
Jackson, Mississippi 39201

WATER WELL DRILLERS LOG

Marion
E 13
11-10-69

11/10 1969 Vesuv Drillers Marion
date well completed firm name county well located

LANDOWNER:

description of formations encountered

from to

Mr. Fred Crawford

Top soil

0-1

Route 1, Foxworthy, Miss.
(mailing address)

red clay

1-20

WELL LOCATION:

Gravel

20-50

sec 7 T 4 N R 12 E
S

red sand

50-90

5 miles North of Vassar
(distance) (direction) (nearest town)

Chalk

90-110

WELL PURPOSE: Home Use
(home, irrigation, municipal, industrial)

fine sand & rock

110-125

WELL COMPLETION DATA:

Water sand &

P gravel

125-150

(1) diameter (inches) 4"

(2) total depth (feet) 150'

(3) static water level (feet) 100' below top of ground.

(4) casing Plastic, 140' (material) (depth)

(size) if telescope see back.

(5) screen 10' length, 140' depth to top

4" Plastic (size) (material)

(6) pump 1/2 HP (HP) (yield gpm)

F.B.M. sub. pump (type power)

(7) electric log No (yes or no)

(organization running log)

(8) how well bottom plugged

CODED


MAR 18 1970

MISS. BD. OF WATER CONTROL

DRILLERS REMARKS:

If well telescopes please sketch and show depths.

GROUND LEVEL

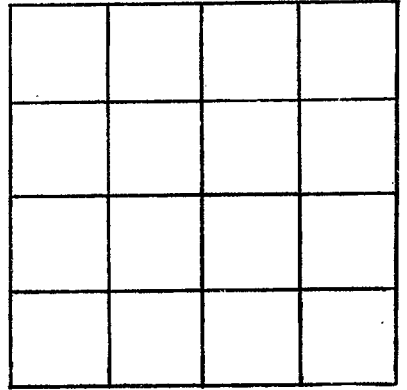

SECTION _____

Please indicate well location X.

ADDITIONAL INFORMATION

If more than one screen, show locations of each on sketch.