

MARION
E 14
10-70

MISSISSIPPI
BOARD OF WATER COMMISSIONERS
416 North State Street
Jackson, Mississippi 39201

CODED

WATER WELL DRILLERS LOG

Oct. 1970 E.B. SHERRARD MARION
date well completed firm name county well located

LANDOWNER:
Roy MILLER
FOXWORTH, MISS.
(mailing address)

description of formations encountered
RED SAND &
VERY LOOSE
PIEA GRAVEL &
LARGE GRAVEL
MIXED 0 129'

WELL LOCATION:
sec 33 T 4 N R 12 E
S W
9 1/2 miles W of COLUMBIA
(distance) (direction) (nearest town)

WELL PURPOSE:
(home irrigation, municipal, industrial)

- WELL COMPLETION DATA:
- (1) diameter (inches) 3"
 - (2) total depth (feet) 129'
 - (3) static water level (feet) 117' below top of ground.
 - (4) casing PL. 12.3' (material) (depth)
3" (size) if telescope see back.
 - (5) screen 6' (length) (depth to top)
3" (size) PLASTIC (material)
 - (6) pump 9 (HP) 9 (yield gpm)
E (type power)
 - (7) electric log (yes or no)
 - (organization running log)
 - (8) how well bottom plugged BWV

CODED

FEB 1 1971

MISS. DD. OF
WATER COMM.


FEB 1 1971

MISS. ED.
WATER COMM.

DRILLERS REMARKS:

If well telescopes please sketch and show depths.

GROUND LEVEL

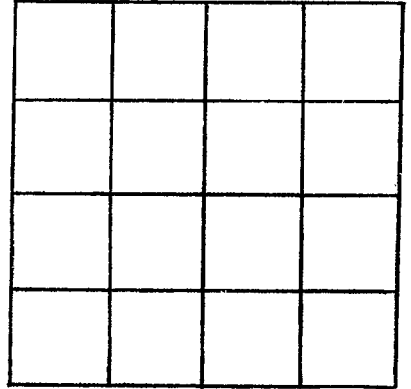

SECTION _____

Please indicate well location X.

ADDITIONAL INFORMATION

If more than one screen, show locations of each on sketch.