

MARION  
E 15  
12-70

MISSISSIPPI  
BOARD OF WATER COMMISSIONERS  
416 North State Street  
Jackson, Mississippi 39201

CODED

WATER WELL DRILLERS LOG

DEC. 1970  
date well completed

E.B. SHERRARD  
firm name

MARTON  
county well located

LANDOWNER:

WELTON SMITH

MORGANTOWN  
(mailing address)

WELL LOCATION:

sec. 10 T. 4 N R. 12 E  
S W  
4 miles WNW MORGANTOWN  
(distance) (direction) (nearest town)

WELL PURPOSE:

(home) irrigation, municipal, industrial

WELL COMPLETION DATA:

- (1) diameter (inches) 4"  
(2) total depth (feet) 172  
(3) static water level (feet) 135 below top of ground.  
(4) casing PL. 162 (material) (depth)  
4" (size) if telescope see back.  
(5) screen 10' (length) (depth to top)  
4" (size) PL. (material)  
(6) pump 3/4 SUB. 15 (HP) (yield gpm)  
E (type power)  
(7) electric log (yes or no)  
(organization running log)  
(8) how well bottom plugged BWV

description of formations encountered

from

to

VERY LOOSE  
SANDY RED  
CLAY MOSTLY  
SAND 0 140'  
SOLID GRAVEL  
BIG LITTLE  
COARSE SAND  
MIXED  
LOOSE WITH  
HARD GRAY CLAY  
BOTTOM 140 172'

CODED


FEB 1 1971

MISS. BD. OF  
WATER COM.

DRILLERS REMARKS:

If well telescopes please  
sketch and show depths.

GROUND LEVEL

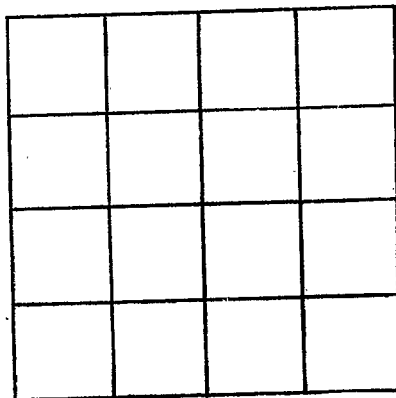

SECTION \_\_\_\_\_

Please indicate well location X.

ADDITIONAL INFORMATION

If more than one screen,  
show locations of each on sketch.