

MARION
E 16
4-6-71

MISSISSIPPI
BOARD OF WATER COMMISSIONERS
416 North State Street
Jackson, Mississippi 39201

CODED

WATER WELL DRILLERS LOG

4-6-71 date well completed
Dean Shivers water well service firm name
Marion county well located

LANDOWNER:	description of formations encountered	from	to
Tommy Shambell	Top soil	0	1
Route 1, Foxworth, Miss. (mailing address)	red clay	1	20
WELL LOCATION:	sand & gravel	20	115
sec: 7 T 4 N R 12 E	Water sand	115	174
1.6 miles West of Columbia (distance) (direction) (nearest town)			
WELL PURPOSE: Home Use (home, irrigation, municipal, industrial)			
WELL COMPLETION DATA:			
(1) diameter (inches) 4"			
(2) total depth (feet) 174'			
(3) static water level (feet) 120' below top of ground.			
(4) casing Plastic, 164' (material) (depth)			
(size) If telescope see back.			
(5) screen 10' length, 164' depth to top			
4" Plastic (size) (material)			
(6) pump 3/4 (HP) (yield gpm)			
(type power)			
(7) electric log (yes or no)			
(organization running log)			
(8) how well bottom plugged			
DRILLERS REMARKS:			


CODED

APR 12 1971

MISS. BD. OF
WATER COM.

If well telescopes please sketch and show depths.

GROUND LEVEL

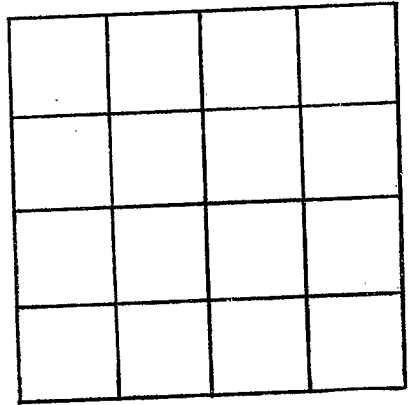

SECTION _____

Please indicate well location X.

ADDITIONAL INFORMATION

If more than one screen, show locations of each on sketch.