

MARION
E 17.
1-71

MISSISSIPPI
BOARD OF WATER COMMISSIONERS
416 North State Street
Jackson, Mississippi 39201

CODED

WATER WELL DRILLERS LOG

JAN. 1971 E.B. SHERRARD MARION
date well completed firm name county well located

LANDOWNER:	description of formations encountered	from	to
LLOYD BRACEY Rt. 1-Foxworth, Miss. (mailing address)	BED SANDY CLAY REDDITCH SAND GRAVEL SMALL PEA GR. & COARSE WHITE SAND	0	40' 140' 178'
WELL LOCATION: sec 22 T 4 N R 22 E S 7 miles NW of Foxworth (distance) (direction) (nearest town)			
WELL PURPOSE: (home) irrigation, municipal, industrial			
WELL COMPLETION DATA:			
(1) diameter (inches) 4"			
(2) total depth (feet) 178			
(3) static water level (feet) 130 below above top of ground.			
(4) casing PL. 168 (material) (depth) 4" (size) if telescope see back.			
(5) screen 10' (length) (depth to top) 4" (size) PL. (material)			
(6) pump 1 (HP) 20 (yield gpm) FL. (type power)			
(7) electric log (yes or no)			
(8) how well bottom plugged BNV (organization running log)			
DRILLERS REMARKS:			


CODED

MAY 27 1971

MISS. Bd. OF
WATER COMM.

If well telescopes please sketch and show depths.

GROUND LEVEL

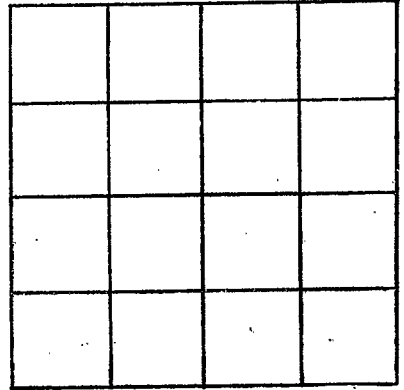

SECTION _____

Please indicate well location X.

ADDITIONAL INFORMATION

If more than one screen, show locations of each on sketch.