

MARION

E 18

7-14-70

MISSISSIPPI
 BOARD OF WATER COMMISSIONERS
 416 North State Street
 Jackson, Mississippi 39201

CODED

WATER WELL DRILLERS LOG

7-14-70
date well completed

Dunn Drives Well Service
firm name

Marion
county well located

LANDOWNER:

Janet Beard

description of formations encountered

top soil

from to

0+1

Route 1 Forworth, Mich.
(mailing address)

red clay

1'-10"

WELL LOCATION:

sec 35 T 4 N R 12 E

sand & gravel

10+80'

10 miles West of Forworth
(distance) (direction) (nearest town)

white chalk

80-100'

WELL PURPOSE: Home Use
(home, irrigation, municipal, industrial)

fine sand

100-140'

water sand

140-170'

WELL COMPLETION DATA:

- (1) diameter (inches) 4"
- (2) total depth (feet) 170'
- (3) static water level (feet) 100' below top of ground.
- (4) casing Plastic, 160'
(material) (depth)
4" If telescope see back.
(size)
- (5) screen 10', 160'
(length) (depth to top)
4", Plastic
(size) (material)
- (6) pump 1/2
(HP) (yield gpm)
(type power)
- (7) electric log _____
(yes or no)
(organization running log)
- (8) how well bottom plugged _____

CODED


JUL 16 1971

DRILLERS REMARKS:

MISS. BD. OF
WATER COM.

If well telescopes please sketch and show depths.

GROUND LEVEL

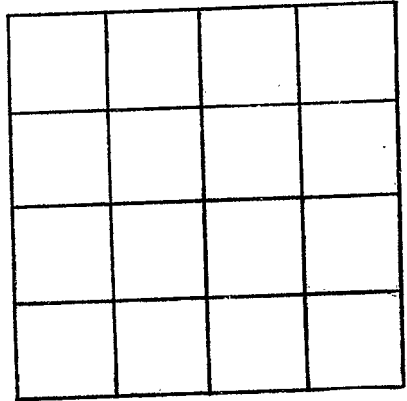

SECTION _____

Please indicate well location X.

ADDITIONAL INFORMATION

A series of horizontal lines for recording additional information.

If more than one screen, show locations of each on sketch.