

MISSISSIPPI  
BOARD OF WATER COMMISSIONERS  
416 North State Street  
Jackson, Mississippi 39201

WATER WELL DRILLERS LOG

**CODED**

Marion  
E-19  
7-71

July 1971 E.B. SHERRARD Marion  
date well completed firm name county well located

LANDOWNER:  
GEORGE HUDSON  
FOXWORTH  
(mailing address)

description of formations encountered  
GRAVEL CLAY  
GRAVEL & SAND  
from 0 to 70'  
170' 129'

WELL LOCATION:  
sec. 22 T 4 N R 12 E  
S W  
10 miles W of COLUMBIA  
(distance) (direction) (nearest town)

WELL PURPOSE:  
(home) Irrigation, municipal, industrial

WELL COMPLETION DATA:  
(1) diameter (inches) 2"  
(2) total depth (feet) 122  
(3) static water level (feet) 95 below above top of ground.  
(4) casing PL. 117.  
(material) (depth)  
2" if telescope see back.  
(size)  
(5) screen 5'  
(length) (depth to top)  
2" PL.  
(size) (material)  
(6) pump 1/2 8  
(HP) (yield gpm)  
E  
(type power)  
(7) electric log (yes or no)  
(organization running log)  
(8) how well bottom plugged B.W.V.

**CODED**


SEP 15 1971  
SLT

DRILLERS REMARKS:

MISS. BD. OF  
WATER COMM.

If well telescopes please sketch and show depths.

GROUND LEVEL

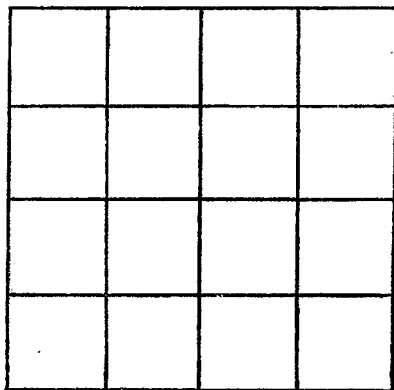

SECTION \_\_\_\_\_

Please indicate well location X.

ADDITIONAL INFORMATION

If more than one screen,  
show locations of each on sketch.