

MARION  
E 20  
5-5-72

MISSISSIPPI  
BOARD OF WATER COMMISSIONERS  
416 North State Street  
Jackson, Mississippi 39201

**CODED**

WATER WELL DRILLERS LOG

5-5 1972 Armen Water Well Drilling Marion  
date well completed firm name county well located

LANDOWNER:

Edwin Ray Bracey  
Route 1 Foltwell, Miss  
(mailing address)

WELL LOCATION:

sec. 21 T. 4 N. R. 12 E.  
1.8 miles W of Chumbino  
(distance) (direction) (nearest town)

WELL PURPOSE:

Home  
(home, irrigation, municipal, industrial)

WELL COMPLETION DATA:

- (1) diameter (inches) 4"
- (2) total depth (feet) 170'
- (3) static water level (feet) — below above top of ground.
- (4) casing Plastic, 160'  
(material) (depth)  
4" if telescope see back.  
(size)
- (5) screen 10' 160'  
(length) (depth to top)  
4" Plastic  
(size) (material)
- (6) pump 3/4 100  
(HP) (yield gpm)  
Electric  
(type power)
- (7) electric log —  
(yes or no)  
—  
(organization running log)
- (8) how well bottom plugged —

description of formations encountered

from

to

TOP Soil	0	1'
gravel	1	25'
Clay	25	53'
gravel	53	86'
Blue Shell	86	90'
Clay	90	121'
Sand	121	135'
Water Sand	135	170'

**CC**


19 1972

DRILLERS REMARKS:

MISS. ED. C.  
WATER COM.

If well telescopes please sketch and show depths.

GROUND LEVEL

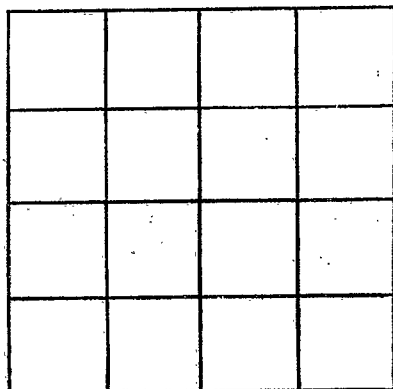

SECTION \_\_\_\_\_

Please indicate well location X.

ADDITIONAL INFORMATION

If more than one screen, show locations of each on sketch.