

MARION  
E 21  
6-72

MISSISSIPPI  
BOARD OF WATER COMMISSIONERS  
416 North State Street  
Jackson, Mississippi 39201

**CODED**

WATER WELL DRILLERS LOG

June 1972 E.B. Sherrard Marion  
date well completed firm name county well located

LANDOWNER:	description of formations encountered	from	to
<u>Woodrow Magee</u> <u>Kokomo, Miss</u> (mailing address)	<u>RED CLAY</u> <u>GRAVEL</u> <u>GRAVEL &amp; SAND</u> <u>MIXED</u>	<u>0</u>	<u>40'</u> <u>78'</u>
<b>WELL LOCATION:</b> sec <u>31</u> T <u>4N</u> S R <u>12E</u> <u>11</u> miles <u>W</u> of <u>Columbus</u> (distance) (direction) (nearest town)			
<b>WELL PURPOSE:</b> <del>(home)</del> irrigation, municipal, industrial			
<b>WELL COMPLETION DATA:</b>			
(1) diameter (inches) <u>2"</u>			
(2) total depth (feet) <u>78'</u>			
(3) static water level (feet) <u>58</u> below above top of ground.			
(4) casing <u>pl.</u> <u>73'</u> (material) (depth) <u>2"</u> (size) if telescope see back.			
(5) screen <u>5'</u> (length) (depth to top) <u>1"</u> <u>pl.</u> (size) (material)			
(6) pump <u>1</u> <u>e</u> (HP) (yield gpm) (type power)			
(7) electric log <u>(yes or no)</u> (organization running log)			
(8) how well bottom plugged <u>BWV</u>			
DRILLERS REMARKS:			


**CODED**

JUL 28 1972

MISS. BLD. OF  
WATER COMM.

If well telescopes please sketch and show depths.

GROUND LEVEL

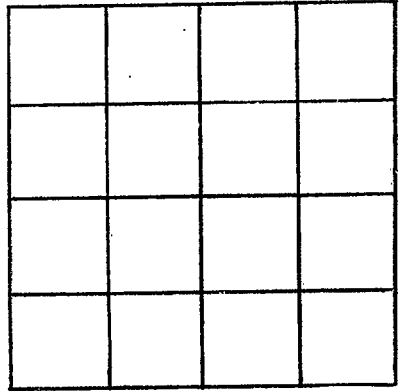

SECTION \_\_\_\_\_

Please indicate well location X.

ADDITIONAL INFORMATION

If more than one screen,  
show locations of each on sketch.