

MARION  
E 23  
6-73

MISSISSIPPI  
BOARD OF WATER COMMISSIONERS  
416 North State Street  
Jackson, Mississippi 39201

CODED

WATER WELL DRILLERS LOG

JUNE 1973  
date well completed

E. R. SHEPARD  
firm name

MARION  
county well located

LANDOWNER:

GLEN M. DUNNAWAY  
FOXWORTH, MISS.  
(mailing address)

description of formations  
encountered

LOOSE RED SANDY  
CLAY 0 90'  
GRAVEL & PEA GR.  
WITH COARSE SAND 90 145'

from

to

WELL LOCATION:

sec. 18 T 4 N R 12 E  
S W  
12 miles NW COLUMBIA  
(distance) (direction) (nearest town)

WELL PURPOSE:

(home irrigation, municipal, industrial)

WELL COMPLETION DATA:

- (1) diameter (inches) 4"  
(2) total depth (feet) 145'  
(3) static water level (feet) 88' below above top of ground.  
(4) casing (material) pl. (depth) 135'  
4" (size) if telescope see back.  
(5) screen (length) 10' (depth to top)  
4" (size) (material) pl.  
(6) pump 3/4 (HP) 15 (yield gpm)  
E (type power)  
(7) electric log (yes or no)  
(organization running log)  
(8) how well bottom plugged BWV

CODED


TABLE 7 10 1370

DRILLERS REMARKS:

REVISION  
DATE

If well telescopes please  
sketch and show depths.

GROUND LEVEL

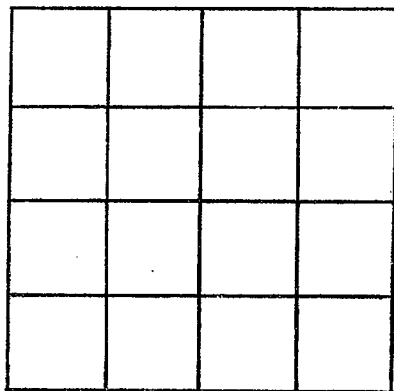

SECTION \_\_\_\_\_

Please indicate well location X.

ADDITIONAL INFORMATION

If more than one screen,  
show locations of each on sketch.