

MARION
E 25
S174

MISSISSIPPI
BOARD OF WATER COMMISSIONERS
416 North State Street
Jackson, Mississippi 39201 **CODED**

WATER WELL DRILLERS LOG

May 24 1974 E.B. Sherrill Marion
date well completed firm name county well located

LANDOWNER:
Mitchell Thornhill
Forsworth, MS.
(mailing address)

description of formations encountered	from	to
<u>HARD BEDCLAY</u>	<u>0</u>	<u>60</u>
<u>SANDY BEDCLAY</u>	<u>60</u>	<u>120</u>
<u>SAND STAKE</u>	<u>120</u>	<u>140</u>

WELL LOCATION:
sec. 6 T. 4 N. R. 12 E.
S W
12 miles NW of Columbia
(distance) (direction) (nearest town)

<u>SAND + RUBERON</u>	<u>140</u>	<u>182</u>
-----------------------	------------	------------

WELL PURPOSE:
(home) irrigation, municipal, industrial

WELL COMPLETION DATA:

(1) diameter (inches) 4"

(2) total depth (feet) 182'

(3) static water level (feet) 90' below above top of ground.

(4) casing pl. 172'
(material) (depth)
4"
(size) if telescope see back.

(5) screen 10' pl.
(length) (depth to top)
4" pl.
(size) (material)

(6) pump 1 20
(HP) (yield gpm)
E
(type power)

(7) electric log (yes or no)

(organization running log)

(8) how well bottom plugged BWV


CODED

RECEIVED
JUL - 1 - 1974

DRILLERS REMARKS:

If well telescopes please sketch and show depths.

GROUND LEVEL

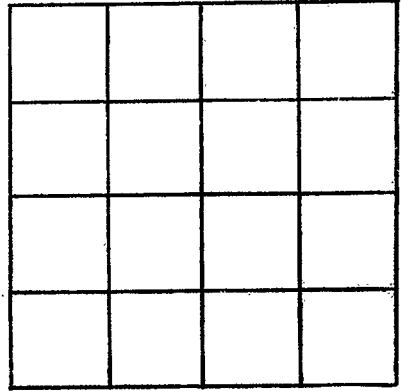

SECTION _____

Please indicate well location X.

ADDITIONAL INFORMATION

If more than one screen, show locations of each on sketch.