

MARION
E 26
12-7-73

MISSISSIPPI
BOARD OF WATER COMMISSIONERS
416 North State Street
Jackson, Mississippi 39201

CODED

WATER WELL DRILLERS LOG

12-7-73 date well completed
GRINER - GINN firm name
Marion county well located

LANDOWNER:
Mrs. Annie Mullins
Rt. 1 Forworth Miss.
(mailing address)

description of formations encountered	from	to
Lopokil	0	1
hard	1	22
gravel	22	58
chalk	58	99
hard	99	165

WELL LOCATION:
sec. 9 T 4 N R 12 E
1.5 miles NW of Forworth
(distance) (direction) (nearest town)

WELL PURPOSE: Home
(home, irrigation, municipal, industrial)

- WELL COMPLETION DATA:
- (1) diameter (inches) 2"
 - (2) total depth (feet) 165
 - (3) static water level (feet) 120 below top of ground.
 - (4) casing plastic, 155,
(material) (depth)
2"
(size) if telescope see back.
 - (5) screen 10', 155.
(length) (depth to top)
2", plastic
(size) (material)
 - (6) pump 1/2, 7
(HP) (yield gpm)
elec.
(type power)
 - (7) electric log NO
(yes or no)
NO
(organization running log)
 - (8) how well bottom plugged
B.W. Valve


CODED

DRILLERS REMARKS:

MISS. Bd. of Water Comm.
JAN 23 1974

If well telescopes please sketch and show depths.

GROUND LEVEL

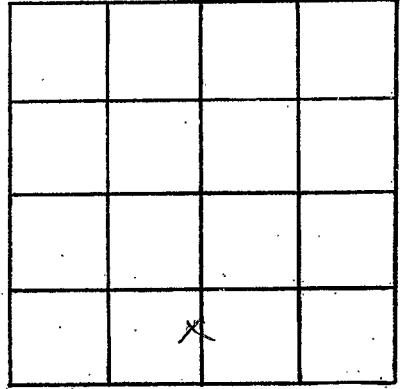

SECTION 9

Please indicate well location X.

ADDITIONAL INFORMATION

If more than one screen, show locations of each on sketch.