

Marion
E 28
7174

MISSISSIPPI
BOARD OF WATER COMMISSIONERS
416 North State Street
Jackson, Mississippi 39201

CODED

WATER WELL DRILLERS LOG

July 19 75 E. B. Sheppard Marion
date well completed firm name county well located

LANDOWNER:

Ms. Gertrude Thompson
Kokomo, Miss.
(mailing address)

description of formations encountered

from to

description of formations encountered	from	to
BED SANDY CLAY	0	80'
SAND & GR.	80	88'
GRAV CLAY	88	90'
COARSE SAND & GR.	90	222'

WELL LOCATION:

sec 27 T 4 N R 12 E
8 miles WNW of Columbia
(distance) (direction) (nearest town)

WELL PURPOSE:

(home, irrigation, municipal, industrial)

WELL COMPLETION DATA:

- (1) diameter (inches) 4"
- (2) total depth (feet) 222
- (3) static water level (feet) 120 ^{below} above top of ground.
- (4) casing pl. 212
(material) (depth)
4" if telescope see back.
(size)
- (5) screen 10'
(length) (depth to top)
4" pl.
(size) (material)
- (6) pump 1 15
(HP) (yield gpm)
E.
(type power)
- (7) electric log (yes or no)

(organization running log)

(8) how well bottom plugged B.W.


DRILLERS REMARKS:

RECEIVED

JULY 8 1975

If well telescopes please sketch and show depths.

GROUND LEVEL

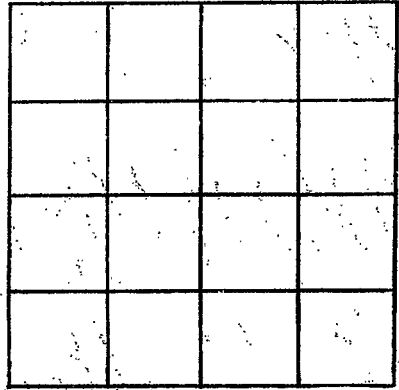

SECTION _____

Please indicate well location X.

ADDITIONAL INFORMATION

If more than one screen, show locations of each on sketch.