

CODED

INDEXED

Marion  
E 29  
8/74

MISSISSIPPI  
BOARD OF WATER COMMISSIONERS  
416 North State Street  
Jackson, Mississippi 39201

WATER WELL DRILLERS LOG

August 1974 E.B. Sherard Marion  
date well completed firm name county well located

LANDOWNER:

Mrs. Eunice Shorthill  
Fopworth, Ms.  
(mailing address)

description of formations encountered

from to

RED SANDY CLAY  
RED CRT & SAND 0 20'  
80' 94'

WELL LOCATION:

sec. 2 T. 4 N R. 12 E  
S W  
8 miles NW of Columbia  
(distance) (direction) (nearest town)

WELL PURPOSE:

(Home) irrigation, municipal, industrial

WELL COMPLETION DATA:

- (1) diameter (inches) 2 1/2"
- (2) total depth (feet) 94'
- (3) static water level (feet) 30' <sup>below</sup> ~~above~~ top of ground.
- (4) casing pl. 89' (material) (depth)  
2" (size) If telescope see back.
- (5) screen 5' (length) (depth to top)  
2" (size) pl. (material)
- (6) pump 1 (HP) 7 (yield gpm)  
E (type power)
- (7) electric log (yes or no)

(organization running log)

(8) how well bottom plugged BWV


DRILLERS REMARKS:

RECEIVED  
MAY 8 1974

MISS. BD. OF WATER COMMISSIONERS

If well telescopes please sketch and show depths.

GROUND LEVEL

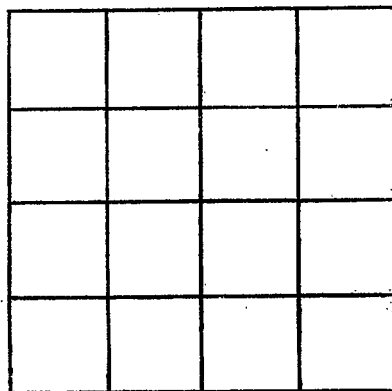

SECTION \_\_\_\_\_

Please indicate well location X.

ADDITIONAL INFORMATION

If more than one screen, show locations of each on sketch.