

Marion
E 30
874

MISSISSIPPI
BOARD OF WATER COMMISSIONERS
416 North State Street
Jackson, Mississippi 39201

CODED

WATER WELL DRILLERS LOG

August 24 1974 E.B. Sheward Marion
date well completed firm name county well located


LANDOWNER:	description of formations encountered	from	to
Sam Carney Forwards, Ms. (mailing address)	GRAVEL & SANDY CLAY STREAKS GRAVEL SAND	0	70' 120'
WELL LOCATION:			
sec 17 T 4 N R 12 E S W 10 miles NW of Forwards (distance) (direction) (nearest town)			
WELL PURPOSE: (home irrigation, municipal, industrial)			
WELL COMPLETION DATA:			
(1) diameter (inches) 4"			
(2) total depth (feet) 120'			
(3) static water level (feet) 40 ^{below} _{above} top of ground.			
(4) casing <u>pl.</u> <u>110'</u> (material) (depth)			
<u>4"</u> (size) if telescope see back.			
(5) screen <u>10'</u> (length) (depth to top)			
<u>4"</u> <u>pl.</u> (size) (material)			
(6) pump <u>1/2</u> <u>15</u> (HP) (yield gpm)			
<u>E</u> (type power)			
(7) electric log (yes or no) <u>(no)</u>			
(organization running log)			
(8) how well bottom plugged <u>BWV</u>			
DRILLERS REMARKS:			

DECEMBER 15 1974
MAY - 8 1975

MISS. BD. OF WATER COMMISSIONERS

If well telescopes please sketch and show depths.

GROUND LEVEL

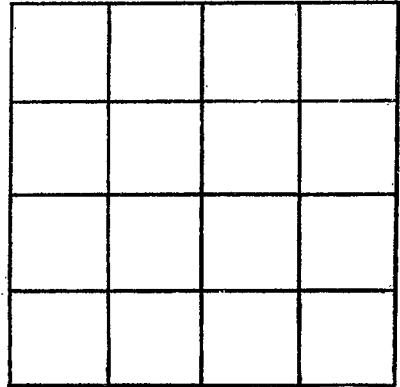

SECTION _____

Please indicate well location X.

ADDITIONAL INFORMATION

If more than one screen, show locations of each on sketch.