


Marion  
E 31  
6-2-75

MISSISSIPPI  
BOARD OF WATER COMMISSIONERS  
416 North State Street  
Jackson, Mississippi 39201

CODED


WATER WELL DRILLERS LOG

June 2 1975 *Reuss Well Drilling* Marion  
date well completed firm name county well located

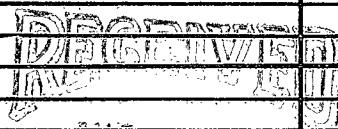LANDOWNER:	description of formations encountered	from	to
Chester Tankley Rt. Monticella (mailing address)	Red Clay Red Chalk sand Sand and gravel Pink Chalk - pea gravel sand	0 26 63 120 129	2 1/2 63 120 129 135
WELL LOCATION: sec. 19 T 4 N R 12 E 134 0.2 miles North of Parkman (distance) (direction) (nearest town)			
WELL PURPOSE: none (home, irrigation, municipal, industrial)			
WELL COMPLETION DATA:			
(1) diameter (inches) 4"			
(2) total depth (feet) 135			
(3) static water level (feet) 63 below top of ground.			
(4) casing plastic, bottom (material) (depth)			
If telescope see back. (size)			
(5) screen 6' 129 (length) (depth to top)			
4" plastic (size) (material)			
(6) pump 7 (HP) 10 (type power) (yield gpm)			
electric (type power)			
(7) electric log no (yes or no)			
(organization running log)			
(8) how well bottom plugged wooden plug			
DRILLERS REMARKS: 2" well played out	 AUG 6 1975		

If well telescopes please sketch and show depths.

GROUND LEVEL

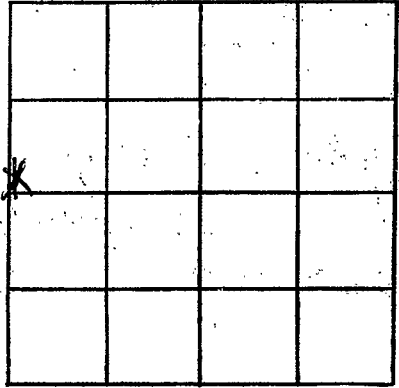

SECTION 19

Please indicate well location X.

ADDITIONAL INFORMATION

If more than one screen, show locations of each on sketch.