

MISSISSIPPI DEPARTMENT OF NATURAL RESOURCES

Bureau of Land and Water Resources

Southport Mall

P.O. Box 10631

Jackson, Mississippi 39209

WATER WELL DRILLERS LOG

CODED

Marion
E 32
9-16-81

9-16-81 date well completed Greener Drilling Service, Inc. firm name Marion county well located

LANDOWNER:	description of formations encountered	from	to
Conoco P.O. Box 1267 Ponca City, Oklahoma (mailing address) 74601	sand, gravel	0	260
WELL LOCATION: 180'S + 1540'E of No. 1 sec. 27 T. 4 N. R. 12 E N.W. 1/4 Willie Starbuck-Fourth Rd. (distance) miles (direction) of (nearest town) et al	clay rocks	260	470
WELL PURPOSE: Oil field (home, irrigation, municipal, industrial) supply	streaked	470	504
WELL COMPLETION DATA:	sand	504	546
(1) diameter (inches) 4"			
(2) total depth (feet) 546'			
(3) static water level (feet) 150' below top of ground.			
(4) casing steel 546' (material) (depth) 4" (size) if telescope see back.			
(5) screen 42' 504' (length) (depth to top) 4" perforated (size) (material)			
(6) pump — 65-70 (HP) (yield gpm) AC (type power)			
(7) electric log — (yes or no) (organization running log)			
(8) how well bottom plugged — mangle peel			
DRILLERS REMARKS:			


DEPT. OF NATURAL RESOURCES
BUREAU OF LAND & WATER RESOURCES

SEP 28 1981

RECEIVED

If well telescopes please sketch and show depths.

GROUND LEVEL

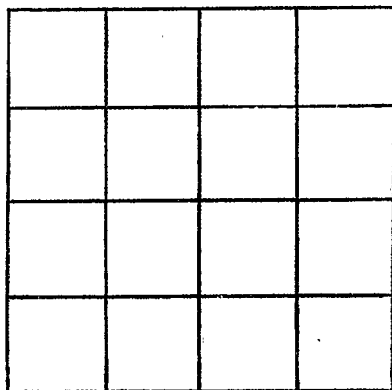

SECTION _____

Please indicate well location X.

ADDITIONAL INFORMATION

If more than one screen, show locations of each on sketch.