

MARION
 E 33
 8-4-81

MISSISSIPPI DEPARTMENT OF NATURAL RESOURCES

Bureau of Land and Water Resources

Southport Mall

P.O. Box 10631

Jackson, Mississippi 39209

WATER WELL DRILLERS LOG

CODED

Aug 4 1981
 date well completed

Reams Well
 firm name

Marion
 county well located

LANDOWNER:

description of formations
 encountered

from to

Darrell Brocay

Clay
 Chalk sand
 sand & gravel
 Chalk sand
 Coarse sand
 fine gravel

0 18
 18 60
 60 98
 98 135
 135 170

Pt Faywath
 (mailing address)

WELL LOCATION:

sec. 19 T 4 N R 2 E
 2 miles NNE of Osburn
 (distance) (direction) (nearest town)

WELL PURPOSE: home & irrigation
 (home, irrigation, municipal, industrial)

WELL COMPLETION DATA:

- (1) diameter (inches) 4"
- (2) total depth (feet) 170
- (3) static water level (feet) 60' below top of ground.
- (4) casing plastic bottom (material) (depth)
- (size) If telescope see back.
- (5) screen 20' length, 150' depth to top
 4" size, plastic material
- (6) pump 5 hp (HP), 115 yield gpm
 shot type power
- (7) electric log no (yes or no)

CODED

(organization running log)

(8) how well bottom plugged

Back wash

DRILLERS REMARKS:


DEPT. OF NATURAL RESOURCES
 BUREAU OF LAND & WATER RESOURCES

FEB - 8 1982

RECEIVED

If well telescopes please sketch and show depths.

GROUND LEVEL

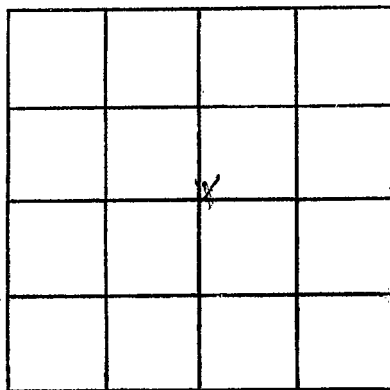

SECTION 19

Please indicate well location X.

ADDITIONAL INFORMATION

If more than one screen,
show locations of each on sketch.