

State Well Report

Part I

Mississippi Department of Environmental Quality
 Office of Land and Water Resources
 P.O. Box 10631
 Jackson, MS 39289-0631
 (601)961-5210
 (601)354-6938 (fax)

County: Mallon
 Permit #: _____
 Driller: Travis Boone
 Date drilling completed: 10-21-04

For Office Use Only
 Aquifer: _____
 Well #: E-107
 L. S. Division: E-65
 E-log #: _____

State Law requires that this report be prepared by the driller in detail and filed with the Department within 30 days of completion of drilling of the well.

Well Owner Information			Well Location		
Owner Name: <u>Joe Peak</u>			Latitude: <u>31° 19' 49"</u>	Longitude: <u>91° 21' 51"</u>	
Mailing Address: <u>Hwy 587</u>			Method of Lat/Long (circle one): <u>Conventional Survey</u>		
<u>Boxworth, MS 39483</u>			USGS quad: <u>Hand-held GPS, Survey-grade GPS</u>		
City: _____	State: _____	Zip Code: _____	<u>SE 1/4 NW 1/4 Sec 12 Twn 4N Rng 19W</u>		
Telephone No. <u>(601) 731-2657</u>			Distance: <u>2.14</u> Miles	Direction: <u>NW</u>	Nearest Town: <u>Morganston</u>

Well Data

Purpose of Well (circle one): Flow Industrial Public Supply Irrigation Fish Culture Other: _____

Date well drilling started: 10-20-04 Date well drilling completed: 10-21-04

If flowing, method of flow regulation: Valve _____ Other (describe): _____

Static Water Level: 203 feet above or below (circle one) land surface Date measured: 10-21-04

Method of Measurement (circle one) steel tape electric tape air line other: string line

Hole depth: _____ Well depth: 390 Well grouted to a depth of 10 feet

Type of grout (circle one): Cement Bentonite Mix

Casing length: 370 feet Casing diameter: 4 inches Type of casing: sch 40

Screen length: 20 feet Screen diameter: 4 inches Type of screen: sch 40

Screen slot size: 8 inches Setting depth: From 370 feet to 390 feet

Type of completion (circle all applicable): Gravel packed Underreamed Telescoped Open hole Natural Development
 Other (describe): _____

Top of lap pipe or reduction in casing: _____ feet. If telescoped or more than one screen, describe on back of page

Logs run (circle all applicable): No log run Electric Gamma Ray Density Sonic Neutron Other: _____

Name of organization running log(s): _____

I certify that the well was drilled, constructed, and completed in accordance with all applicable requirements of the Mississippi Department of Environmental Quality and/or the Mississippi Department of Health regulations and state laws.

Travis Boone 0-514
 Print Name of Water Well Contractor and License No.

Travis Boone
 Signature of Water Well Contractor


RECEIVED
 NOV 19 2004
 BY: OLWR

9)

If well telescopes please sketch below and show depths.

Ground Level

F-107

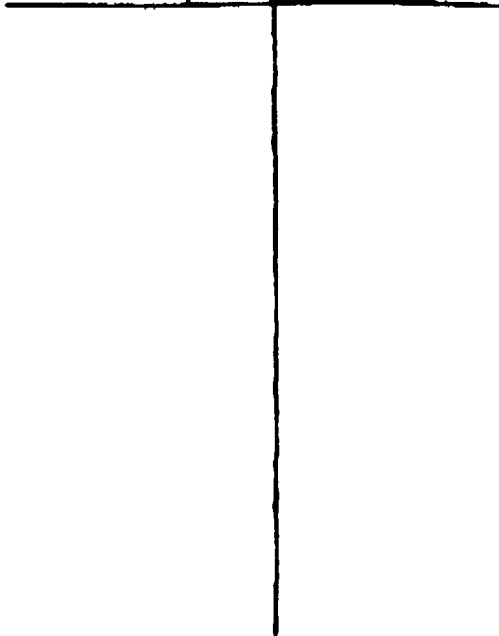

Description of Formations Encountered	From	To
Clay	0	30
Sand + Gravel	30	110
Clay	110	355
Sand	355	390

If more than one screen, show location of each on sketch

Sketch the property layout and include the following: 1) the well location; 2) any permanent structures on the property that may aid in locating the well; 3) any roads, power lines, or other items that may aid in locating the property and the well; 4) indicate direction.

power pole

red bluff

Landowner Name: Joe Peak

RECEIVED
NOV 19 2004
BY: OLWR

Travis Beave
Signature of Water Well Contractor

This customer would not give a complete physical address. He did not pay for his well in full now he has changed his phone # to unlisted. The location is directly across the road where Dot is setting up to do come through with the new road at Red Bluff. on Hwy 587 in Foxworth.

STATE WELL REPORT

Part 2

Pump Installer's Completion Report
 Mississippi Department of Environmental Quality
 Office of Land and Water Resources
 P.O. Box 10631
 Jackson, MS 39289-0631
 (601)961-5210
 (601)354-6938 (fax)

County: Maxwell
 Permit #: _____
 Diller: Travis Boone
 Date completed: 10-21-04

For Office Use Only:
 Aquifer: UG-5
 Well #: E-107
 Elevation: _____

This report should be prepared by the pump installer in detail and filed with the Department within 30 days of the installation of pump.

Well Owner Information	Well Location
Owner Name: <u>Joe Peak</u>	Latitude: _____ Longitude: _____
Mailing Address: <u>Hwy 587</u>	Method of Lat/Long (circle one): <u>Conventional Survey</u>
<u>Joxworth, MS 39483</u>	USGS quad, Hand-held GPS, Survey-grade GPS
City: _____ State: _____ Zip Code: _____	<u>5E 4 N 14 W Sec 12 Twn 44 Rng 19W</u>
Telephone No. <u>(601) 731-2657</u>	Distance: _____ Direction: _____ Nearest Town: <u>120</u>
	<u>2 3/4 Miles NW of Morgantown</u>

Pump Type Circle one	Power Type Circle one
Air Lift <input type="checkbox"/> Jet <input type="checkbox"/> <u>Submersible</u>	Diesel Engine <input type="checkbox"/> Gasoline Engine <input type="checkbox"/> Natural Gas <input type="checkbox"/>
Bucket <input type="checkbox"/> Piston <input type="checkbox"/> Turbine <input type="checkbox"/>	<u>Electric Motor</u> <input type="checkbox"/> Hand <input type="checkbox"/> Tractor PTO <input type="checkbox"/>
Centrifugal <input type="checkbox"/> Rotary <input type="checkbox"/> Flowing Well <input type="checkbox"/>	Windmill <input type="checkbox"/> Other (specify): _____
Other (specify): _____	Horse Power Rating of Motor: _____
Date Pump Installed: <u>10-21-04</u>	Setting Depth: <u>300</u> feet
Rated Pump Capacity: _____ Gallons Per Minute	Number of Stages: _____

Pump Test Data	Method of Measuring Water Level Circle one
Date Well Tested: <u>10-21-04</u>	Air Line <input type="checkbox"/> Electric Measuring Line <input type="checkbox"/> <u>Steel Tape</u>
Static Water Level (A): <u>203</u> Feet Below Land Surface	Other (specify): <u>string line</u>
Pumping Water Level (B): _____ Feet Below Land Surface	For flowing well, measured shut in head: _____ feet
Drawdown (B) - (A): _____ Feet Below Land Surface	Well yielded _____ GPM with a drawdown of _____ feet after _____ hours of pumping
Test Pumping Rate: _____ Gallons Per Minute	
Duration of Pump Test (minimum 4 hours): _____ hours	

I HEREBY CERTIFY that the above statements are true to the best of my knowledge.

Travis Boone 0-514
 Right Name of Pump Installer and License No. (if applicable)

Travis Boone
 Signature of Pump Installer

RECEIVED
 NOV 19 2004
 BY: OLWR