

Marion
 E 2000
 5/31/77

MISSISSIPPI
 BOARD OF WATER COMMISSIONERS
 416 North State Street
 Jackson, Mississippi 39201

WATER WELL DRILLERS LOG

May-31-1977 ^{13V} Dunn Well Serv Marion
 date well/completed firm name county well located

LANDOWNER:
Mr. Herman Krauss
Rte 1 Loxworth, Miss
 (mailing address)

| description of formations encountered | from | to |
|---------------------------------------|------------|------------|
| <u>Top Soil</u> | <u>0</u> | <u>1</u> |
| <u>Clay</u> | <u>1</u> | <u>17</u> |
| <u>Clay & gravel</u> | <u>17</u> | <u>39</u> |
| <u>Chalk</u> | <u>39</u> | <u>104</u> |
| <u>Shale</u> | <u>104</u> | <u>116</u> |
| <u>Chalk</u> | <u>116</u> | <u>142</u> |
| <u>Sand</u> | <u>142</u> | <u>185</u> |

WELL LOCATION:
 sec. 15 T 4 N R 12 E W
in miles S of Holly Springs
 (distance) (direction) (nearest town)

WELL PURPOSE: Home
 (home, irrigation, municipal, industrial)

- WELL COMPLETION DATA:
- (1) diameter (inches) 4"
 - (2) total depth (feet) 185'
 - (3) static water level (feet) 130 below top of ground.
 - (4) casing Plastic, 155 ft.
 (material) (depth)
4"
 (size) If telescope see back.
 - (5) screen 20 ft., 155
 (length) (depth to top)
4", Plastic
 (size) (material)
 - (6) pump 1 12
 (HP) (yield gpm)
Elec
 (type power)
 - (7) electric log no
 (yes or no)

(organization running log)

(8) how well bottom plugged B.W. Valve


DRILLERS REMARKS:

RECEIVED
 OCT 25 1977

MISS. BD. OF WATER COMMISSIONERS

If well telescopes please sketch and show depths.

GROUND LEVEL

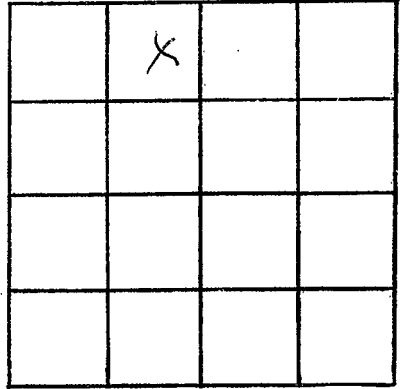

SECTION 15

Please indicate well location X.

ADDITIONAL INFORMATION

If more than one screen, show locations of each on sketch.