

Marion
 E 2001
 7-75

MISSISSIPPI
 BOARD OF WATER COMMISSIONERS
 416 North State Street
 Jackson, Mississippi 39201

WATER WELL DRILLERS LOG

July 1975 E.B. Sherrard Marion
 date well completed firm name county well located

LANDOWNER:
 Joe Murphy
 Columbia, Ms.
 (mailing address)

description of formations encountered	from	to
RED SANDY CLAY & LOOSE GR. STREAKS & CLAY SEPARATORS	0	120'
CORAL SAND & PEA GR.	120'	145'
	145'	155'

WELL LOCATION:
 sec 13 T 4 N R 12 E 13V
 6 miles W of Columbia
 (distance) (direction) (nearest town)

WELL PURPOSE:
 (home, irrigation, municipal, industrial)

- WELL COMPLETION DATA:
- (1) diameter (inches) 2"
 - (2) total depth (feet) 155'
 - (3) static water level (feet) 80' ^{below} above top of ground.
 - (4) casing (material) pl. (depth) 150'
 - 2" (size) if telescope see back.
 - (5) screen 5' (length) (depth to top)
 - 2" (size) pl. (material)
 - (6) pump 1 1/2 (HP) 7 (yield gpm)
 - E (type power)
 - (7) electric log (yes or no) (no)
 - (organization running log)
 - (8) how well bottom plugged B/W


DRILLERS REMARKS:

RECEIVED
 DEC 5 1975

MISS. BD. OF WATER COMMISSIONERS

If well telescopes please
sketch and show depths.

GROUND LEVEL

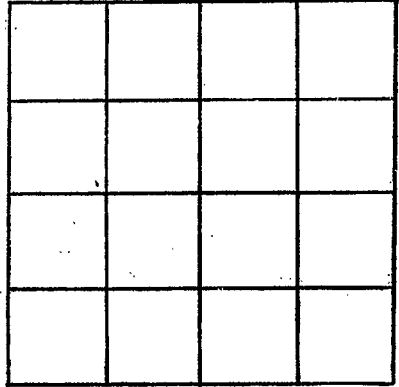

SECTION _____

Please indicate well location X.

ADDITIONAL INFORMATION

If more than one screen,
show locations of each on sketch.