

Marion
E 7002
9/75

MISSISSIPPI
BOARD OF WATER COMMISSIONERS
416 North State Street
Jackson, Mississippi 39201

WATER WELL DRILLERS LOG

Sept. 75 E.B. Sheppard Marion
date well completed firm name county well located

LANDOWNER:
Oredia Bridges
Rt. 1 Faywood, Ms.
(mailing address)

description of formations encountered	from	to
RED SANDY CLAY	0	60'
GRAVEL SANDY CLAY	60	120'
SAND & GRAVEL	120	155'

WELL LOCATION:
sec. 7 T. 4 N. R. 12 E. 13 W.
12 miles NW of Columbia
(distance) (direction) (nearest town)

WELL PURPOSE:
 (home) irrigation, municipal, industrial


- WELL COMPLETION DATA:
- (1) diameter (inches) 2"
 - (2) total depth (feet) 155'
 - (3) static water level (feet) 78' below top of ground.
 - (4) casing pl. 150'
(material) (depth)
2" if telescope see back.
(size)
 - (5) screen 5' pl.
(length) (depth to top)
2" pl.
(size) (material)
 - (6) pump 1 7
(HP) (yield gpm)
E
(type power)
 - (7) electric log (yes or no)
 - (organization running log)
 - (8) how well bottom plugged BWV

DRILLERS REMARKS:

RECEIVED
DEC - 5 1975
MISS. BD. OF WATER COMMISSIONERS

If well telescopes please sketch and show depths.

GROUND LEVEL

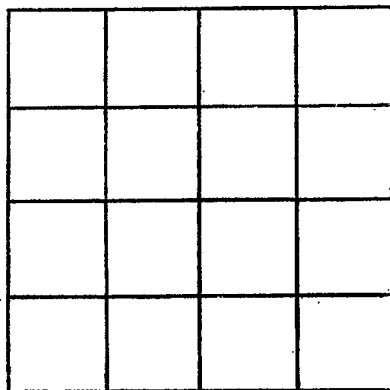

SECTION _____

Please indicate well location X.

ADDITIONAL INFORMATION

If more than one screen,
show locations of each on sketch.