

**MISSISSIPPI
BOARD OF WATER COMMISSIONERS**
416 North State Street
Jackson, Mississippi 39201

Marion
BE 2003
9-19-75

WATER WELL DRILLERS LOG

9-19 ^{13V} **1975** **Gruber-Brown** **Marion**
date well completed firm name county well located

LANDOWNER:

Eldridge, Morgan
Rt. 1 Foxworth
(mailing address)

description of formations encountered

from to

Top Soil	0	1
Clay	1	16
Chalk	46	92
SAND	92	135

WELL LOCATION:

sec. 11 T. 4N R. 20E
4 miles NW of Morganston
(distance) (direction) (nearest town)

WELL PURPOSE:


Home
(home, irrigation, municipal, industrial)

WELL COMPLETION DATA:

- (1) diameter (inches) 2"
- (2) total depth (feet) 135
- (3) static water level (feet) 90 below above top of ground.
- (4) casing PVC, 125,
(material) (depth)
2" if telescope see back.
(size)
- (5) screen 10', 125
(length) (depth to top)
2", PVC
(size) (material)
- (6) pump 1 elec
(HP) (yield gpm)
(type power)
- (7) electric log NO
(yes or no)

(organization running log)

- (8) how well bottom plugged B.W. Valve

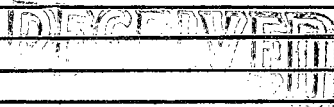

DEC 22 1975

DRILLERS REMARKS:

