

Marion
 E 2005
 3/76

MISSISSIPPI
 BOARD OF WATER COMMISSIONERS
 416 North State Street
 134 Jackson, Mississippi 39201

WATER WELL DRILLERS LOG

March 1976 E.B. Sheward Marion
 date well completed firm name county well located

LANDOWNER:

Robert Dixon
 Rt. 1 - Foxworth, Ms.
 (mailing address)

description of formations encountered

SAND + GRAVEL 0 67'

from to

WELL LOCATION:

sec 16 T 4 N R 12 E
 S W
 8 miles NW Foxworth
 (distance) (direction) (nearest town)

WELL PURPOSE:

(home) Irrigation, municipal, industrial

WELL COMPLETION DATA:

- (1) diameter (inches) 2"
- (2) total depth (feet) 67'
- (3) static water level (feet) 40' below top of ground.
- (4) casing (material) pl. (depth) 62'
- 2" (size) if telescope see back.
- (5) screen (length) 5' (depth to top) 2'
- 2" (size) pl. (material)
- (6) pump (HP) 1 (yield gpm) 7
- E. (type power)
- (7) electric log (yes or no) (no)

(organization running log)

(8) how well bottom plugged BNV


DRILLERS REMARKS:

RECEIVED
 OCT 18 1976

MISS. BD. OF WATER COMM

If well telescopes please sketch and show depths.

GROUND LEVEL

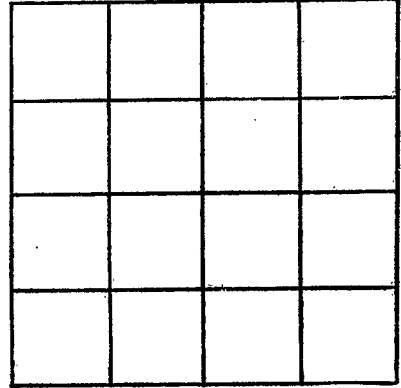

SECTION _____

Please indicate well location X.

ADDITIONAL INFORMATION

If more than one screen, show locations of each on sketch.