

Marion
E 2006
4/76

MISSISSIPPI
BOARD OF WATER COMMISSIONERS
416 North State Street
Jackson, Mississippi 39201

WATER WELL DRILLERS LOG

April 1976 E.B. Sheppard Marion
date well completed firm name county well located

LANDOWNER:
W.E. McAllister
Morgan Station, Miss.
(mailing address)

description of formations encountered	from	to
LOOSE SAND + GRAVEL	0	116'

WELL LOCATION:
sec. 11 T. 4 N R. 12 E
S W
8 miles NW of Fayetteville
(distance) (direction) (nearest town)

WELL PURPOSE:
(home, irrigation, municipal, industrial)

- WELL COMPLETION DATA:
- (1) diameter (inches) 2"
 - (2) total depth (feet) 116'
 - (3) static water level (feet) 97' ^{below} _{above} top of ground.
 - (4) casing pl. 111' (material) (depth)
2" (size) If telescope see back.
 - (5) screen 5' (length) (depth to top)
2" pl. (size) (material)
 - (6) pump 1 1/2 (HP) 6 (yield gpm)
elec. (type power)
 - (7) electric log (yes or no)
 - (8) how well bottom plugged B.W.V.


DRILLERS REMARKS:

RECEIVED
OCT 18 1976

MISS. BD. OF WATER COMMISSIONERS

If well telescopes please sketch and show depths.

GROUND LEVEL

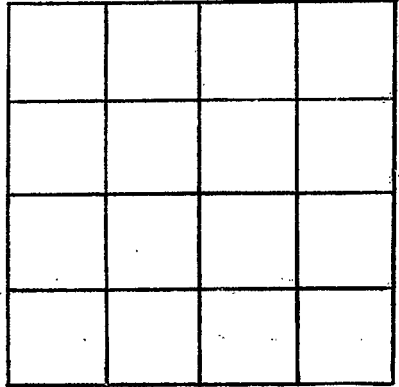

SECTION _____

Please indicate well location X.

ADDITIONAL INFORMATION

If more than one screen, show locations of each on sketch.