

Marion
E 9007
4/19/76

MISSISSIPPI
BOARD OF WATER COMMISSIONERS
416 North State Street
Jackson, Mississippi 39201

WATER WELL DRILLERS LOG
GRINER - GINN

4-19-76 date well completed firm name Marion county well located

LANDOWNER:
Jerome Foxworth
Rt. 2 Box 99 Foxworth,
(mailing address) Miss

description of formations encountered	from	to
Sap Soil	0	1
clay	1	33
clay & chert	23	45
chert	45	54
Sand	54	85

WELL LOCATION:
sec. 33 T 4 N R 12 E
S W
3 miles E of DARBUR
(distance) (direction) (nearest town)

WELL PURPOSE: HOME
(home, irrigation, municipal, industrial)

- WELL COMPLETION DATA:
- (1) diameter (inches) 4"
 - (2) total depth (feet) 8.5
 - (3) static water level (feet) 25 below above top of ground.
 - (4) casing PVC 25'
(material) (depth)
4" if telescope see back.
(size)
 - (5) screen 10' 75'
(length) (depth to top)
4" PVC
(size) (material)
 - (6) pump 3/4 13 ✓
(HP) (yield gpm)
elec
(type power)
 - (7) electric log NO
(yes or no)


(organization running log)
 - (8) how well bottom plugged B.W. Valve.

DRILLERS REMARKS:

RECEIVED
OCT 12 1976
MISS. BD. OF WATER COMMISSIONERS

If well telescopes please
sketch and show depths.

GROUND LEVEL

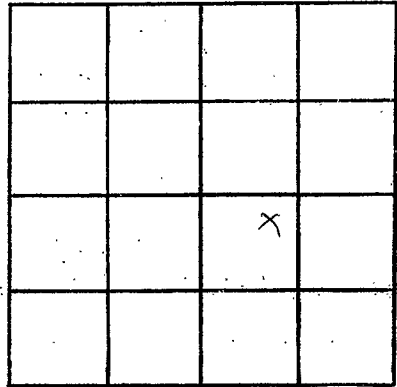

SECTION 33

Please indicate well location X.

ADDITIONAL INFORMATION

If more than one screen,
show locations of each on sketch.