

MARION

E 209

10-27-78

MISSISSIPPI BOARD OF WATER COMMISSIONERS
416 North State Street
Jackson, Mississippi 39201

WATER WELL DRILLERS LOG
TOM GRIFFITH
PLUMBING & WELL SERVICE, INC. *Marion*

10-27-78
date well completed

320 MAYSON AVE.
COLUMBIA, MS 39129

county well located

LANDOWNER:

Louis C. Spiers
8412 Apple St
New Orleans (mailing address)

description of formations encountered

from to

<i>Top Soil</i>	<i>0</i>	<i>16</i>
<i>Clay</i>	<i>4</i>	<i>12</i>
<i>Chalk</i>	<i>12</i>	<i>86</i>
<i>San J. Sand</i>	<i>86</i>	<i>170</i>
<i>Sand</i>	<i>120</i>	<i>180</i>

WELL LOCATION:

sec. *15* T *4* N R *15* E
S W
4 miles *N* of *Proprietor*
(distance) (direction) (nearest town)

WELL PURPOSE: *Domestic*
(home, irrigation, municipal, industrial)

WELL COMPLETION DATA:

- (1) diameter (inches) *2"*
- (2) total depth (feet) *130 ft.*
- (3) static water level (feet) *120 ft.* below top of ground.
- (4) casing *plastic* *160 ft.*
(material) (depth)
2" if telescope see back.
(size)
- (5) screen *20 ft.* *160 ft.*
(length) (depth to top)
2" *plastic*
(size) (material)
- (6) pump *1 HP* *10*
(HP) (yield gpm)
Electric
(type power)
- (7) electric log *no*
(yes or no)

(organization running log)

(8) how well bottom plugged
Back Wash Valve

DRILLERS REMARKS:


RECEIVED

DEC 13 1978

MISS. BD. OF WATER COMM

If well telescopes please sketch and show depths.

GROUND LEVEL

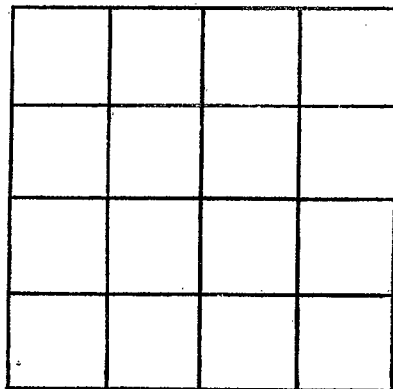

SECTION _____

Please indicate well location X.

ADDITIONAL INFORMATION

If more than one screen,
show locations of each on sketch.