


MARION
E
7-18-78

MISSISSIPPI
BOARD OF WATER COMMISSIONERS
416 North State Street
Jackson, Mississippi 39201

WATER WELL DRILLERS LOG

2010
July 18 1978 *Revere Well Co* Marion
date well completed firm name county well located

LANDOWNER:	description of formations encountered	from	to
<i>O. D. Stompley</i> <i>At 1 Foxworth</i> (mailing address)	<i>Red Clay</i> <i>sand & gravel</i> <i>white Chalk</i> <i>fine sand</i> <i>Coar sand</i>	0 13 110 160 182	13 110 160 182
WELL LOCATION: sec <i>25</i> T <i>4</i> N R <i>12</i> E <i>5</i> miles <i>N-NE</i> of <i>Foxworth</i> (distance) (direction) (nearest town)			
WELL PURPOSE: <i>Home</i> (home, irrigation, municipal, industrial)			
WELL COMPLETION DATA: (1) diameter (inches) <i>4"</i> (2) total depth (feet) <i>204</i> (3) static water level (feet) <i>160</i> below top of ground. above (4) casing <i>plastic bottom</i> (material) (depth) <i>2</i> if telescope see back. (size) (5) screen <i>10'</i> <i>194"</i> (length) (depth to top) <i>4"</i> <i>plastic</i> (size) (material) (6) pump <i>1.5hp</i> <i>15</i> (HP) (yield gpm) <i>chest</i> (type power) (7) electric log <i>no</i> (yes or no) (organization running log)			
(8) how well bottom plugged <i>wooden plug</i>			
DRILLERS REMARKS: <i>Replaced old Red pump</i>			

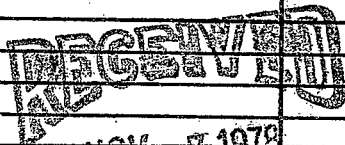


NOV - 7 1978

MISS. DD. OF WATER COMMISSIONERS

If well telescopes please sketch and show depths.

GROUND LEVEL

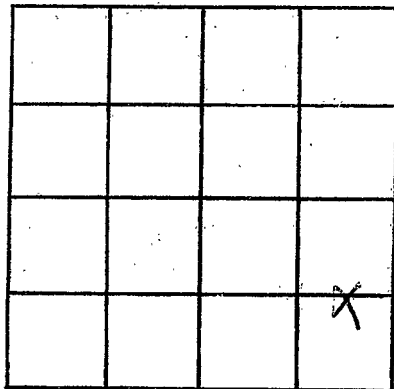

SECTION 25

Please indicate well location X.

ADDITIONAL INFORMATION

If more than one screen,
show locations of each on sketch.