

MARION

E

12-26-78

211

MISSISSIPPI
 BOARD OF WATER COMMISSIONERS
 416 North State Street
 Jackson, Mississippi 39201

WATER WELL DRILLERS LOG

12-26-1978 *Fitzgerald Well Serv* *Marion*
 date well completed firm name county well located

LANDOWNER:	description of formations encountered	from	to
<i>Bobby Priest</i>			
<i>R.R. Folewithers -</i> (mailing address)	<i>Red clay</i>	<i>0</i>	<i>20</i>
	<i>Red sand</i>	<i>20</i>	<i>90</i>
	<i>Coarse sand & gravel</i>	<i>90</i>	<i>110</i>

LANDOWNER:

Bobby Priest

R.R. Folewithers -
(mailing address)


WELL LOCATION:

sec. 31 T 4 N R 12 E
 S W
1 miles E of Darben
 (distance) (direction) (nearest town)

WELL PURPOSE: Home
 (home, irrigation, municipal, industrial)

WELL COMPLETION DATA:

- (1) diameter (inches) 4
- (2) total depth (feet) 110
- (3) static water level (feet) 65 below top of ground.
- (4) casing PVC, 102,
 (material) (depth)
4 If telescope see back.
 (size)
- (5) screen 8, 102
 (length) (depth to top)
4, PVC
 (size) (material)
- (6) pump 1/2, 10
 (HP) (yield gpm)
Electric
 (type power)
- (7) electric log no
 (yes or no)
 (organization running log)
- (8) how well bottom plugged Sand plug

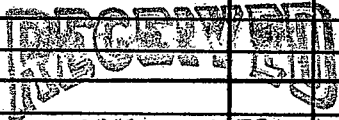


JAN 26 1978

DRILLERS REMARKS:

If well telescopes please sketch and show depths.

GROUND LEVEL

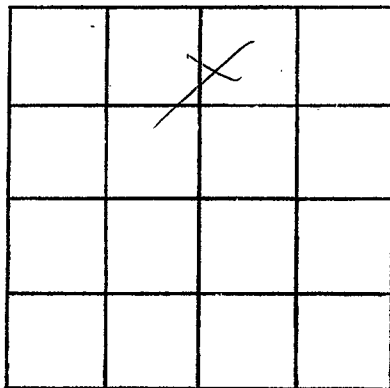

SECTION 31

Please indicate well location X.

ADDITIONAL INFORMATION

If more than one screen, show locations of each on sketch.