

MARION

E

9-18-78

MISSISSIPPI  
BOARD OF WATER COMMISSIONERS  
416 North State Street  
Jackson, Mississippi 39201

## WATER WELL DRILLERS LOG

2012  
Sept 18 1978 Reeves Miller marion  
date well completed firm name county well located

## LANDOWNER:

description of formations encountered

from

to

Jerrey Corbarn

Rt 1 Foyworth miss  
(mailing address)

<u>Red clay</u>	<u>0</u>	<u>20</u>
<u>Red sand</u>	<u>20</u>	<u>78</u>
<u>sand &amp; gravel</u>	<u>78</u>	<u>85</u>
<u>pink chert</u>	<u>85</u>	<u>96</u>
<u>gravel &amp; sand</u>	<u>96</u>	<u>109</u>

## WELL LOCATION:

sec. 18 T 4 N R 12 E

10 miles W. NW of Foyworth  
(distance) (direction) (nearest town)

## WELL PURPOSE:

Shop  
(home, irrigation, municipal, industrial)

## WELL COMPLETION DATA:

- (1) diameter (inches) 4"
- (2) total depth (feet) 109'
- (3) static water level (feet) 78 below above top of ground.
- (4) casing plastic bottom  
(material) (depth)
- if telescope see back.  
(size)
- (5) screen 5' 104'  
(length) (depth to top)
- 4" plastic  
(size) (material)
- (6) pump 3 hp 12  
(HP) (yield gpm)
- list  
(type power)
- (7) electric log NO  
(yes or no)

—  
(organization running log)

(8) how well bottom plugged closed plug


DRILLERS REMARKS:

RECEIVED  
JAN 15 1979

MISS. BD. OF WATER COMM.

If well telescopes please  
sketch and show depths.

GROUND LEVEL

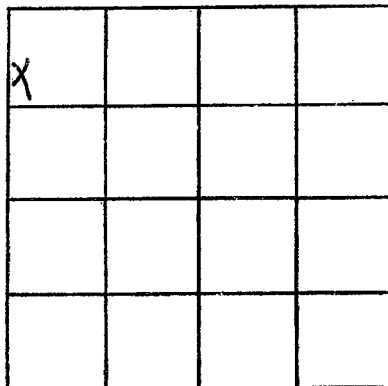

SECTION 18

Please indicate well location X.

ADDITIONAL INFORMATION

If more than one screen,  
show locations of each on sketch.