

Marion
E 2013
3/19/79

MISSISSIPPI
BOARD OF WATER COMMISSIONERS
416 North State Street
Jackson, Mississippi 39201
WATER WELL DRILLERS LOG

3/19 1979 Hollinger Marion
date well completed firm name county well located

LANDOWNER: Thomas
McAllister
Rt 1, more spoutown
(mailing address)

description of formations encountered	from	to
sand, chalk, gravel	0	100
pea gravel	100	117

WELL LOCATION:
2 sec 12 T 4 N S R 79 E W
5 miles NW of more spoutown
(distance) (direction) (nearest town)

WELL PURPOSE:
(home, irrigation, municipal, industrial)

WELL COMPLETION DATA:
(1) diameter (inches) 2"
(2) total depth (feet) 117
(3) static water level (feet) 60 below top of ground.
(4) casing PVC, 107, (material) (depth)
(size) If telescope see back.
(5) screen 10, 107 (length) (depth to top)
1/2", PVC (size) (material)
(6) pump 1 1/2 HP, 11 (HP) (yield gpm)
elect (type power)
(7) electric log (yes or no)
(organization running log)

(8) how well bottom plugged sand
SHARK
DRILLERS REMARKS: good well


Office: Board of Water Comm.

MAY 14 1979

RECEIVED

If well telescopes please sketch and show depths.

GROUND LEVEL

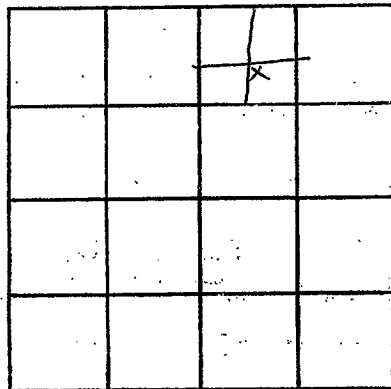

SECTION 12

Please indicate well location X.

ADDITIONAL INFORMATION

If more than one screen, show locations of each on sketch.