

Marion
E 214
3-16-79

MISSISSIPPI
BOARD OF WATER COMMISSIONERS
416 North State Street
Jackson, Mississippi 39201

WATER WELL DRILLERS LOG

3/16 1979 Hollingsworth Well Marion
date well completed firm name county well located

LANDOWNER:	description of formations encountered	from	to
Joseph Peake RT1			
Morgantown, Ms. (mailing address)	CLAY, CHALK, SAND pea gravel	0	100 100 114

WELL LOCATION:
? sec 12 T 19 N R 19 E
S W
5 miles NW of Morgantown
(distance) (direction) (nearest town)

WELL PURPOSE:
(home, irrigation, municipal, industrial)

- WELL COMPLETION DATA:
- (1) diameter (inches) 2"
 - (2) total depth (feet) 114
 - (3) static water level (feet) 100 below above top of ground.
 - (4) casing PVC 110 (material) (depth)
 - (size) If telescope see back.
 - (5) screen 5 110 (length) (depth to top)
 - 2" PVC (size) (material)
 - (6) pump 1 1/2 10 (HP) (yield gpm)
 - elect (type power)
 - (7) electric log (yes or no)

(organization running log)

(8) how well bottom plugged SAND SHARIE

DRILLERS REMARKS: good well


Office Board of Water Comm.

MAY 14 1979

RECEIVED

If well telescopes please sketch and show depths.

GROUND LEVEL

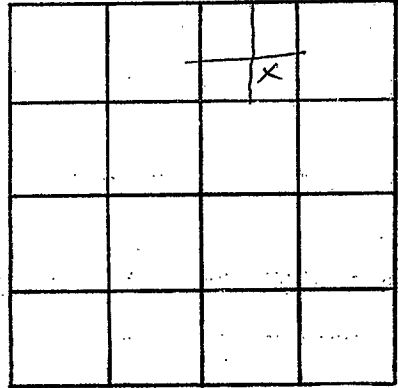

SECTION 12

Please indicate well location X.

ADDITIONAL INFORMATION

If more than one screen,
show locations of each on sketch.