

MARION
E 2015
3-7-79

MISSISSIPPI
BOARD OF WATER COMMISSIONERS
416 North State Street
Jackson, Mississippi 39201

WATER WELL DRILLERS LOG

March 7 1979 Reeves Miller Marion
date well completed firm name county well located

LANDOWNER:
Donald Bazman
At Foyworth
(mailing address)

description of formations encountered	from	to
<u>Red Clay</u>	<u>0</u>	<u>25</u>
<u>Red Chalk band</u>	<u>25</u>	<u>135</u>
<u>Gravel sand</u>	<u>135</u>	<u>158</u>
<u>pink chalk</u>	<u>158</u>	<u>170</u>
<u>pea gravel sand</u>	<u>170</u>	<u>184</u>

WELL LOCATION:
sec. 18 T-4 N R-12 E
9 miles N-NW of Foyworth
(distance) (direction) (nearest town)

WELL PURPOSE: house
(home, irrigation, municipal, industrial)

WELL COMPLETION DATA:

(1) diameter (inches) 4"

(2) total depth (feet) 184'

(3) static water level (feet) 140 below above top of ground.

(4) casing plastic, bottom
(material) (depth)

— If telescope see back.
(size)

(5) screen 5', 179'
(length) (depth to top)

4", plastic
(size) (material)

(6) pump 3 sub, 12
4 (HP) (yield gpm)

split
(type power)

(7) electric log no
(yes or no)

—
(organization running log)

(8) how well bottom plugged wooden plug

DRILLERS REMARKS:
—


Miss. Board of Water Comm.

JUN 19 1979

RECEIVED

If well telescopes please sketch and show depths.

GROUND LEVEL

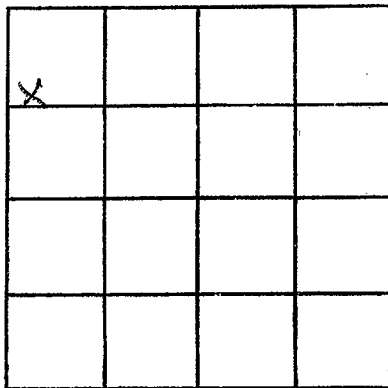

SECTION 18

Please indicate well location X.

ADDITIONAL INFORMATION

If more than one screen, show locations of each on sketch.