

MARION
E 2016
3-12-79

MISSISSIPPI
BOARD OF WATER COMMISSIONERS
416 North State Street
Jackson, Mississippi 39201

WATER WELL DRILLERS LOG

3-12-79
date well completed

1979 TOM GRIFFITH
PLUMBING & WELL SERVICE, INC.

Miss.
county well located

LANDOWNER:

Elijah Rogers
Rt. 1 Box 105 Fort Worth, Miss.
(mailing address)

description of formations encountered

description of formations encountered	from	to
Topsoil	0	2
Clay	2	7
Sand	7	8 1/2
Chalk	8 1/2	10 1/2
Sh. S.	10 1/2	15 1/2

WELL LOCATION:

sec. 3 T. 4 N. R. 12 E.
S. W.
4 miles NW of *Marion*
(distance) (direction) (nearest town)

WELL PURPOSE:

Dom.
(home, irrigation, municipal, industrial)

WELL COMPLETION DATA:

- (1) diameter (inches) 2"
- (2) total depth (feet) 15 1/2 ft.
- (3) static water level (feet) 110 ft. below top of ground.
- (4) casing plastic 135 ft.
(material) (depth)
- 2" if telescope see back.
(size)
- (5) screen 10 ft. 135 ft.
(length) (depth to top)
- 2" plastic
(size) (material)
- (6) pump 1 HP 10 gals
(HP) (yield gpm)
- Electric
(type power)
- (7) electric log No
(yes or no)

(organization running log)

(8) how well bottom plugged
Back Wash Valve

DRILLERS REMARKS:


Miss. Board of Water Comm.

JUL 5 1979

RECEIVED

If well telescopes please sketch and show depths.

GROUND LEVEL

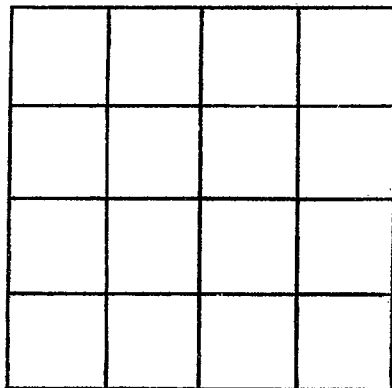

SECTION _____

Please indicate well location X.

ADDITIONAL INFORMATION

If more than one screen, show locations of each on sketch.