

MARION

E 207

3-1-79

MISSISSIPPI BOARD OF WATER COMMISSIONERS

416 North State Street

Jackson, Mississippi 39201

Reynolds Walker
WATER WELL DRILLERS LOG

March 1 1979
date well completed

Reynolds Walker
firm name

Marion
county well located

LANDOWNER:

Dwight McCain
Rt Kayworth
(mailing address)

description of formations encountered

from

to

<i>Red sandy clay</i>	<i>0</i>	<i>25</i>
<i>Red chalky silt</i>	<i>25</i>	<i>135</i>
<i>granite sand</i>	<i>135</i>	<i>156</i>
<i>pink Chalk</i>	<i>156</i>	<i>168</i>
<i>fine gravel and</i>	<i>168</i>	<i>183</i>

WELL LOCATION:

sec. *18* T *4* N R *12* E
9 miles *N-NW* of *Kayworth*
(distance) (direction) (nearest town)

WELL PURPOSE:

Trailer
(home, irrigation, municipal, industrial)

WELL COMPLETION DATA:

- (1) diameter (inches) *4*
- (2) total depth (feet) *183*
- (3) static water level (feet) *138* below top of ground.
- (4) casing *plastic bottom*
(material) (depth)
- (size) if telescope see back.
- (5) screen *5'* *178'*
(length) (depth to top)
- 4"* *plastic*
(size) (material)
- (6) pump *1 1/2 hp* *15*
(HP) (yield gpm)
- elect*
(type power)
- (7) electric log *no*
(yes or no)

(organization running log)

(8) how well bottom plugged

Wooden plug

DRILLERS REMARKS:


Miss. Board of Water Comm.

JUN 18 1979

RECEIVED

If well telescopes please sketch and show depths.

GROUND LEVEL

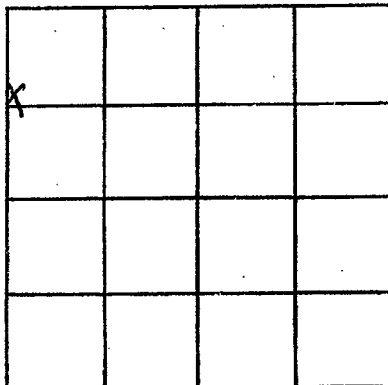

SECTION 18

Please indicate well location X.

ADDITIONAL INFORMATION

Lined area for additional information.

If more than one screen, show locations of each on sketch.