

MARION
E 2018
3-14-79

MISSISSIPPI
BOARD OF WATER COMMISSIONERS
 416 North State Street
 Jackson, Mississippi 39201

WATER WELL DRILLERS LOG
TOM GRIFFITH

3-14-79 19 **PLUMBING & WELL SERVICE, INC.** *Marion*
 date well completed firm name county well located

LANDOWNER:
J. L. Dunaway
Rt. 1, Jofwork Miss.
 (mailing address)

description of formations encountered	from	to
<i>Top Soil</i>	<i>0</i>	<i>1</i>
<i>clay</i>	<i>1</i>	<i>7</i>
<i>clay</i>	<i>7</i>	<i>18</i>
<i>Sand & Gravel</i>	<i>18</i>	<i>61</i>
<i>clay</i>	<i>61</i>	<i>89</i>
<i>Sand</i>	<i>89</i>	<i>102</i>
<i>Gravel</i>	<i>102</i>	<i>118</i>
<i>Sand & Gravel</i>	<i>118</i>	<i>150</i>

WELL LOCATION:
 sec. *27* T. *4* N. R. *12* E.
 S. W.
6 miles *W* of *Jofwork*
 (distance) (direction) (nearest town)

WELL PURPOSE: *Home*
 (home, irrigation, municipal, industrial)

- WELL COMPLETION DATA:**
- (1) diameter (inches) *7"*
 - (2) total depth (feet) *130 ft.*
 - (3) static water level (feet) *110 ft.* below above top of ground.
 - (4) casing *plastic* *160 ft.*
 (material) (depth)
2"
 (size) if telescope see back.
 - (5) screen *20 ft.* *160 ft.*
 (length) (depth to top)
2" *plastic*
 (size) (material)
 - (6) pump *2 HP* *10 gals*
 (HP) (yield gpm)
Electric
 (type power)
 - (7) electric log *no*
 (yes or no)

(organization running log)

(8) how well bottom plugged *Back wash valve*

DRILLERS REMARKS:


Miss. Board of Water Comm.

JUL 5 1979

RECEIVED

If well telescopes please sketch and show depths.

GROUND LEVEL

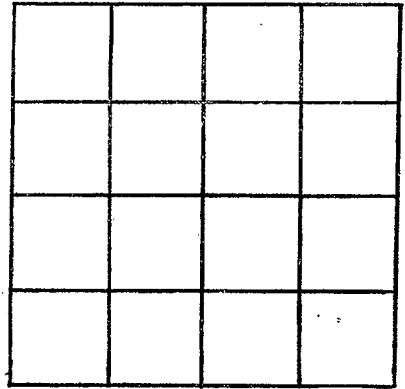

SECTION _____

Please indicate well location X.

ADDITIONAL INFORMATION

If more than one screen,
show locations of each on sketch.