

Marion
E 2019

MISSISSIPPI
BOARD OF WATER COMMISSIONERS
416 North State Street
Jackson, Mississippi 39201

WATER WELL DRILLERS LOG

11-13-79

11/13 date well completed

1979 Hollingsworth firm/name

MARION county well located

LANDOWNER: Patricia Taylor
RT 1
Foxworth, MS
(mailing address)

description of formations encountered	from	to
	<u>sand, gravel</u>	<u>0</u>
<u>chert gravel</u>	<u>100</u>	<u>140</u>
<u>pea gravel</u>	<u>140</u>	<u>175</u>

WELL LOCATION:
sec. 22 T 4 N 12 S R 20 E
8 miles W of Shorsboro
(distance) (direction) (nearest town)

WELL PURPOSE:
(home, irrigation, municipal, industrial)

- WELL COMPLETION DATA:
- (1) diameter (inches) 4
 - (2) total depth (feet) 185
 - (3) static water level (feet) 140 below above top of ground.
 - (4) casing pvc (material) (depth)
(size) If telescope see back.
 - (5) screen 10 175
(length) (depth to top)
4 pvc
(size) (material)
 - (6) pump 1 1/2 20
(HP) (yield gpm)
elect
(type power)
 - (7) electric log (yes or no)

(organization running log)

(8) how well bottom plugged sand
sharp

DRILLERS REMARKS: good well


DEPT. OF NATURAL RESOURCES
BUREAU OF LAND & WATER RESOURCES

JAN 15 1980

RECEIVED

If well telescopes please sketch and show depths.

GROUND LEVEL

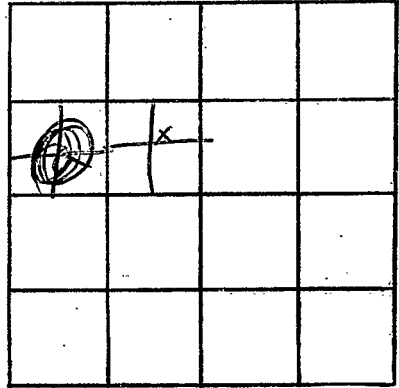

SECTION 22

Please indicate well location X.

ADDITIONAL INFORMATION

If more than one screen,
show locations of each on sketch.