

Marion
E 2020
1-2-80

MISSISSIPPI
 BOARD OF WATER COMMISSIONERS
 416 North State Street
 Jackson, Mississippi 39201

WATER WELL DRILLERS LOG

1-2 1980 Hollinger MARION
 date well completed firm name county well located

LANDOWNER: Watts Newell
RT 1
Kokomo
 (mailing address)

description of formations encountered	from	to
	<u>sand, gravel</u>	<u>0</u>
<u>clay</u>	<u>100</u>	<u>120</u>
<u>perm. gravel</u>	<u>120</u>	<u>148</u>

WELL LOCATION:
 sec. 20 T. 4 (N) R. 12 (E)
 S W
2 miles NE of Marion
 (distance) (direction) (nearest town)

WELL PURPOSE: Home Water
 (home, irrigation, municipal, industrial)

- WELL COMPLETION DATA:
- (1) diameter (inches) 4"
 - (2) total depth (feet) 145
 - (3) static water level (feet) 50 below above top of ground.
 - (4) casing PVC, 135,
 (material) (depth)
 (size) If telescope see back.
 - (5) screen 10, 135
 (length) (depth to top)
4, PVC
 (size) (material)
 - (6) pump 1, 18
 (HP) (yield gpm)
elect
 (type power)
 - (7) electric log yes or no

(organization running log)
 (8) how well bottom plugged SHARK
SHARK

DRILLERS REMARKS: good well


DEPT. OF NATURAL RESOURCES
 BUREAU OF LAND & WATER RESOURCES

JAN 15 1980

RECEIVED

If well telescopes please sketch and show depths.

GROUND LEVEL

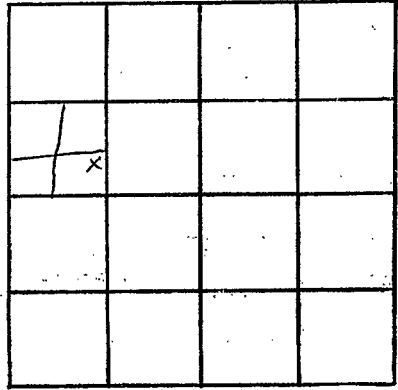

SECTION 20

Please indicate well location X.

ADDITIONAL INFORMATION

If more than one screen, show locations of each on sketch.