

MARION

MISSISSIPPI
BOARD OF WATER COMMISSIONERS
416 North State Street
Jackson, Mississippi 39201

WATER WELL DRILLERS LOG

E 2002

6-16-80

6-16

1980

Hollinger

Marion

date well completed

firm name

county well located

LANDOWNER: Alton Jensen

description of formations encountered

from to

Rt 1

Ferwood


(mailing address)

CLAY, GRAVEL CHALK
Sand, gravel

0 80
80 147

WELL LOCATION:

sec. 25 T 40 N

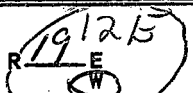

4 miles W of Morganston
(distance) (direction) (nearest town)

WELL PURPOSE: Home
(home, irrigation, municipal, industrial)

WELL COMPLETION DATA:

- (1) diameter (inches) 2"
- (2) total depth (feet) 147
- (3) static water level (feet) 70 below top of ground.

- (4) casing PVC, 142
(material) (depth)
- (size) If telescope see back.

- (5) screen 5, 142
(length) (depth to top)
- (size) (material)

- (6) pump 1, 7
(HP) (yield gpm)
- elect
(type power)

- (7) electric log
(yes or no)
- (organization running log)

- (8) how well bottom plugged SAND
SHARK

DRILLERS REMARKS: good well


DEPT. OF NATURAL RESOURCES
BUREAU OF LAND & WATER RESOURCES

JUL 21 1980

RECEIVED

If well telescopes please sketch and show depths.

GROUND LEVEL

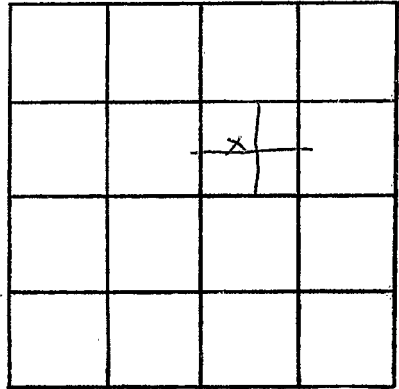

SECTION 25

Please indicate well location X.

ADDITIONAL INFORMATION

If more than one screen, show locations of each on sketch.