


MARION  
E 2023  
6-17-80

MISSISSIPPI  
BOARD OF WATER COMMISSIONERS  
416 North State Street  
Jackson, Mississippi 39201

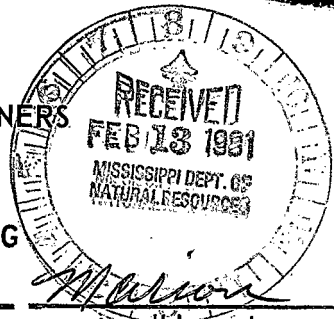

WATER WELL DRILLERS LOG

June 17 1980 date well completed  
Reems Miller firm name  
Marion county well located

LANDOWNER:  
Vernon  
Vernon Cunningham  
At 1 Kokomo  
(mailing address)

description of formations encountered	from	to
Red Clay	0	22
Red sand	22	115
peaground & chert	115	130
sand & fls gravel	130	140


WELL LOCATION:  
sec. 6 T. 4 N R. 12 E  
9 1/2 miles north of Kokomo  
(distance) (direction) (nearest town)

WELL PURPOSE: house  
(home, irrigation, municipal, industrial)

- WELL COMPLETION DATA:
- (1) diameter (inches) 4"
  - (2) total depth (feet) 140'
  - (3) static water level (feet) 90' below top of ground
  - (4) casing plastic, bottom  
(material) (depth)
  - (size) if telescope see back.
  - (5) screen 3' 135'  
(length) (depth to top)
  - 4" plastic  
(size) (material)
  - (6) pump byathers  
(HP) (yield gpm)
  - elect  
(type power)
  - (7) electric log no  
(yes or no)
  - (organization running log)

(8) how well bottom plugged  
Dashwash valve

DRILLERS REMARKS:

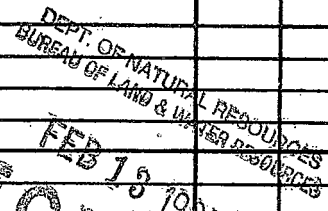

If well telescopes please sketch and show depths.

GROUND LEVEL

			X

SECTION 6

Please indicate well location X.

ADDITIONAL INFORMATION

If more than one screen,  
show locations of each on sketch.