

SW Dechun Wood Co. Well Drill Co.

MARION
E 2024
7-30-80

MISSISSIPPI
BOARD OF WATER COMMISSIONERS
416 North State Street
Jackson, Mississippi 39201

WATER WELL DRILLERS LOG

7-30 19 80 Hollinger MARION
date well completed firm name county well located

LANDOWNER: Roy Smith
RT1
Furworth, Mrs
(mailing address)

description of formations encountered	from	to
gravel, sand	0	100
chert	100	130
pea gravel	130	160

WELL LOCATION:
sec. 17 T 4 N R 12 E
3 miles SW of Jackson
(distance) (direction) (nearest town)

WELL PURPOSE:
(home, irrigation, municipal, industrial)

WELL COMPLETION DATA:
(1) diameter (inches) 2
(2) total depth (feet) 165
(3) static water level (feet) 80 (below/above top of ground)
(4) casing PVC, 155 (material) (depth)
(size) if telescope see back.
(5) screen 10, 155 (length) (depth to top)
2, PVC (size) (material)
(6) pump 2, 9 (HP) (yield gpm)
elect (type power)
(7) electric log (yes or no)
(organization running log)

(8) how well bottom plugged sand SHARK
DRILLERS REMARKS: good


DEPT. OF NATURAL RESOURCES
BUREAU OF LAND & WATER RESOURCES

OCT 20 1980

RECEIVED

If well telescopes please sketch and show depths.

GROUND LEVEL

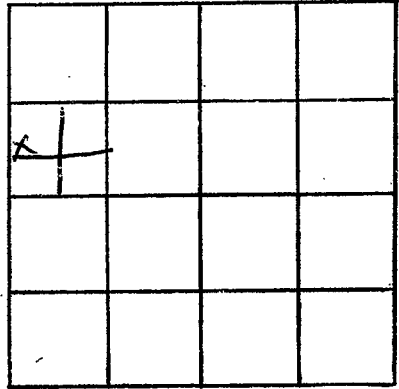

SECTION 17

Please indicate well location X.

ADDITIONAL INFORMATION

If more than one screen, show locations of each on sketch.