

Marion
E 225
10-1-80

MISSISSIPPI
BOARD OF WATER COMMISSIONERS
416 North State Street
Jackson, Mississippi 39201

WATER WELL DRILLERS LOG

10-1 1980 Hollinger Marion
date well completed firm name county well located

LANDOWNER: Richard Connolly RT 1 Foxworth Mrs. (mailing address)	description of formations encountered	from	to
	Sand, gravel	0	100
	CHALK gravel	100	140
	pea gravel	140	190
WELL LOCATION: sec. 21 T 40 N R 20 E S 4 W of Marion (distance) (direction) (nearest town)			
WELL PURPOSE: Home (home, irrigation, municipal, industrial)			
WELL COMPLETION DATA: (1) diameter (inches) 2" (2) total depth (feet) 190 (3) static water level (feet) 108 below top of ground. (4) casing PVC 180 (material) (depth) (size) if telescope see back. (5) screen 10 180 (length) (depth to top) 2 PVC (size) (material) (6) pump 1 9 (HP) (yield gpm) elect (type power) (7) electric log (yes or no) (organization running log) (8) how well bottom plugged Sand SHARK			
DRILLERS REMARKS: Good well			


DEPT. OF NATURAL RESOURCES
BUREAU OF LAND & WATER RESOURCES

OCT 20 1980

RECEIVED

If well telescopes please sketch and show depths.

GROUND LEVEL

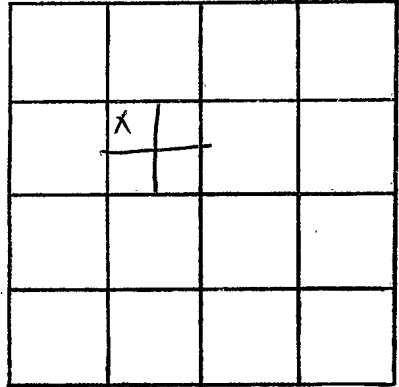

SECTION 21

Please indicate well location X.

ADDITIONAL INFORMATION

If more than one screen, show locations of each on sketch.