

Marion  
E 2024  
7-6-81

MISSISSIPPI  
BOARD OF WATER COMMISSIONERS  
416 North State Street  
Jackson, Mississippi 39201

WATER WELL DRILLERS LOG

7-6 date well completed      81 Hollinger firm name      Marion county well located

LANDOWNER:	description of formations encountered	from	to
Marsh of Bend			
RT 1 Foxworth, MS	Red clay	0	30
	gravel	30	95
	sand	95	112

(mailing address)  
WELL LOCATION:  
sec. 3 T 4N R 20E  
5 miles NW of Foxworth  
(distance) (direction) (nearest town)

WELL PURPOSE:  
(home, irrigation, municipal, industrial)


- WELL COMPLETION DATA:
- (1) diameter (inches) 2"
  - (2) total depth (feet) 112
  - (3) static water level (feet) 102 below top of ground.
  - (4) casing (material) (depth) (size) If telescope see back.
  - (5) screen 5 105 (length) (depth to top) (size) (material) PVC
  - (6) pump 1 1/2 5 (HP) (yield gpm) elect (type power)
  - (7) electric log (yes or no)
  - (organization running log)
  - (8) how well bottom plugged sand 5 HAKIC

DRILLERS REMARKS: good well

DEPT. OF NATURAL RESOURCES  
BUREAU OF LAND & WATER RESOURCES


AUG 26 1981

RECEIVED

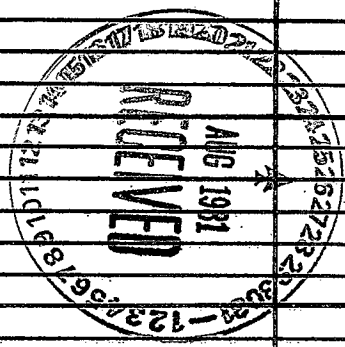

If well telescopes please sketch and show depths.

GROUND LEVEL

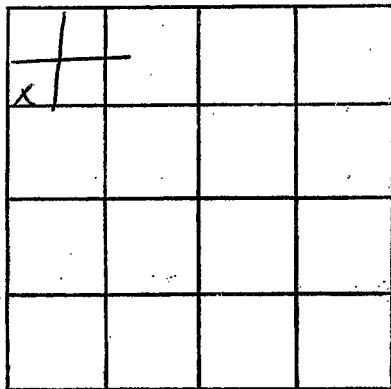

SECTION 3

Please indicate well location X.

ADDITIONAL INFORMATION

A series of horizontal lines for writing additional information.

If more than one screen, show locations of each on sketch.