

Marion
E 2027
6-2-81

MISSISSIPPI
BOARD OF WATER COMMISSIONERS
416 North State Street
Jackson, Mississippi 39201

WATER WELL DRILLERS LOG


6-2-81 date well completed 1981 Hollinger firm name Marion county well located

LANDOWNER: <u>Olma McLean</u> <u>RT1</u>	description of formations encountered	from	to
<u>Foxworth, Ms</u> (mailing address)	<u>Red clay gravel</u> <u>CHALK</u> <u>pink gravel</u>	<u>0</u> <u>100</u> <u>160</u>	<u>100</u> <u>160</u> <u>200</u>
WELL LOCATION:			
sec. <u>13</u> T. <u>40</u> N. R. <u>20</u> E <u>6</u> miles <u>NW</u> of <u>Foxworth</u> (distance) (direction) (nearest town)			
WELL PURPOSE: (home, irrigation, municipal, industrial)			
WELL COMPLETION DATA:			
(1) diameter (inches) <u>2</u> "			
(2) total depth (feet) <u>200</u>			
(3) static water level (feet) <u>100</u> <u>below</u> top of ground.			
(4) casing <u>PVC</u> , <u>195</u> (material) (depth)			
(size) _____ if telescope see back.			
(5) screen <u>5</u> , <u>195</u> (length) (depth to top)			
<u>2</u> , <u>PVC</u> (size) (material)			
(6) pump <u>1 1/2</u> , <u>8</u> (HP) (yield gpm)			
<u>elect</u> (type power)			
(7) electric log _____ (yes or no)			
_____ (organization running log)			
(8) how well bottom plugged <u>SAND</u> <u>SHARK</u>			
DRILLERS REMARKS: <u>Good well</u>			

DEPT. OF NATURAL RESOURCES
BUREAU OF LAND & WATER RESOURCES


AUG 26 1981

RECEIVED

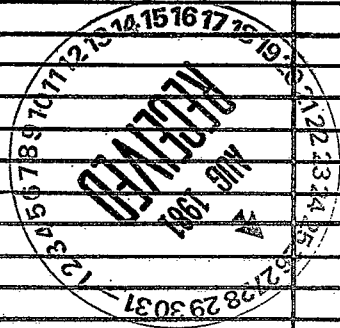

If well telescopes please sketch and show depths.

GROUND LEVEL

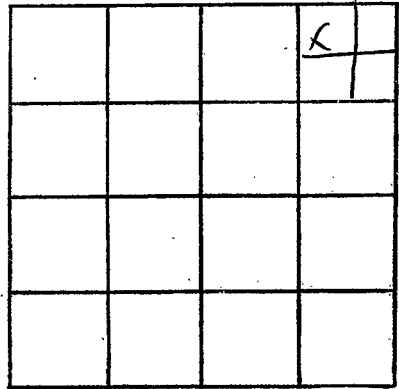

SECTION 13

Please indicate well location X.

ADDITIONAL INFORMATION

Lined area for additional information.

If more than one screen, show locations of each on sketch.