

MARION
E 2028
9-15-81

MISSISSIPPI
BOARD OF WATER COMMISSIONERS
416 North State Street
Jackson, Mississippi 39201

WATER WELL DRILLERS LOG

9-15-81 19 Tom Griffith Well Serv Marion
date well completed firm name county well located

LANDOWNER Clay Hammond description of formations encountered from to
Rt 1 Box 999A
Foxworth miss top soil 0 3
(mailing address) Red clay shale 3 50
White sand 50 110

WELL LOCATION: 12 E
sec. 23 T 4 N R 20
3 miles West of Wesson
(distance) (direction) (nearest town)

WELL PURPOSE: Home
(home, irrigation, municipal, industrial)

WELL COMPLETION DATA:

- (1) diameter (inches) 2 in.
- (2) total depth (feet) 110 feet
- (3) static water level (feet) 25 below above top of ground.
- (4) casing Steel 110
(material) (depth)
2 in
(size) if telescope see back.
- (5) screen 20 feet 110-90
(length) (depth to top)
2 in Steel
(size) (material)
- (6) pump 1 10
(HP) (yield gpm)
Electric
(type power)
- (7) electric log no
(yes or no)
n/a
(organization running log)
- (8) how well bottom plugged B, W, U

DRILLERS REMARKS:


DEPT. OF NATURAL RESOURCES
BUREAU OF LAND & WATER RESOURCES

OCT 20 1981

RECEIVED

If well telescopes please sketch and show depths.

GROUND LEVEL

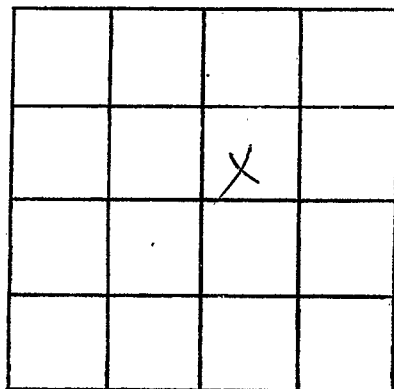

SECTION 23

Please indicate well location X.

ADDITIONAL INFORMATION

If more than one screen,
show locations of each on sketch.