

MISSISSIPPI DEPARTMENT OF NATURAL RESOURCES

Bureau of Land and Water Resources

Southport Mall

P.O. Box 10631

Jackson, Mississippi 39209

WATER WELL DRILLERS LOG

MARION
E 2029


July 19 1981 Recess well logs MARION
date well completed firm name county well located

LANDOWNER:	description of formations encountered	from	to
<u>Ray Thornhill</u> <u>Rt. Foxworth</u> (mailing address)	<u>red clay</u>	<u>0</u>	<u>15</u>
	<u>red sand</u>	<u>15</u>	<u>70</u>
	<u>granite sand</u>	<u>70</u>	<u>92</u>
	<u>lignite & blue clay</u>	<u>92</u>	<u>140</u>
	<u>fine sand</u>	<u>140</u>	<u>190</u>
	<u>sand & pebbles</u>	<u>190</u>	<u>211</u>
WELL LOCATION: sec <u>36</u> T <u>4</u> N R <u>12</u> E <u>5</u> miles <u>W, NW</u> of <u>Foxworth</u> (distance) (direction) (nearest town)			
WELL PURPOSE: <u>Tractor</u> (home, irrigation, municipal, industrial)			
WELL COMPLETION DATA:			
(1) diameter (inches) <u>4"</u>			
(2) total depth (feet) <u>211'</u>			
(3) static water level (feet) <u>140'</u> below top of ground.			
(4) casing <u>plastic</u> , <u>bottom</u> (material) (depth)			
_____ (size) if telescope see back.			
(5) screen <u>10'</u> , <u>201</u> (length) (depth to top)			
_____ (size), _____ (material)			
(6) pump <u>3 hp</u> , <u>12</u> (HP) (yield gpm)			
_____ (type power)			
(7) electric log <u>no</u> (yes or no)			
_____ (organization running log)			
(8) how well bottom plugged <u>Backwash valve</u>			
DRILLERS REMARKS: _____			

DEPT. OF NATURAL RESOURCES
BUREAU OF LAND & WATER RESOURCES
FEB 8 1981
RECEIVED

If well telescopes please sketch and show depths.

GROUND LEVEL

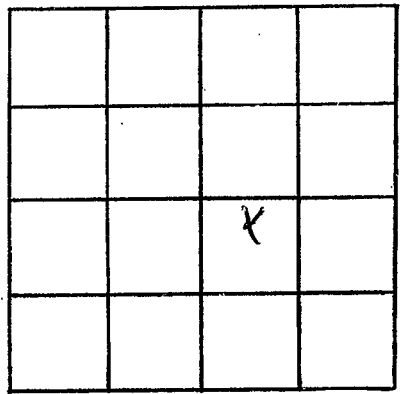

SECTION 36

Please indicate well location X.

ADDITIONAL INFORMATION

If more than one screen,
show locations of each on sketch.