

MISSISSIPPI DEPARTMENT OF NATURAL RESOURCES

Bureau of Land and Water Resources

Southport Mall

P.O. Box 10631

Jackson, Mississippi 39209

WATER WELL DRILLERS LOG

Marion
E
2030

4-28-1982 date well completed Hollinger firm name Marion county well located

LANDOWNER: <u>Circle Bar Farm</u>	description of formations encountered	from	to
<u>2-3-4 Doyala Bldg</u> <u>New Orleans, La.</u> (mailing address)	<u>Chalk</u>	<u>0</u>	<u>20</u>
	<u>sand</u>	<u>20</u>	<u>100</u>
	<u>Chalk</u>	<u>100</u>	<u>215</u>
	<u>pea gravel</u>	<u>215</u>	<u>230</u>
<p>WELL LOCATION: sec. <u>27</u> T <u>4</u> N R <u>20</u> E S W <u>1.5</u> miles <u>W</u> of <u>Foxworth</u> (distance) (direction) (nearest town)</p>			
<p>WELL PURPOSE: (home, irrigation, municipal, industrial)</p>			
<p>WELL COMPLETION DATA:</p>			
<p>(1) diameter (inches) <u>4"</u></p>			
<p>(2) total depth (feet) <u>250 ft</u></p>			
<p>(3) static water level (feet) <u>120</u> ^{below} <u>above</u> top of ground.</p>			
<p>(4) casing <u>PVC</u> (material), _____ (depth), _____ (size) if telescope see back.</p>			
<p>(5) screen <u>10</u> (length), <u>240</u> (depth to top)</p>			
<p><u>4</u> (size), <u>PVC</u> (material)</p>			
<p>(6) pump _____ (HP) _____ (yield gpm)</p>			
<p>_____ (type power)</p>			
<p>(7) electric log _____ (yes or no)</p>			
<p>_____ (organization running log)</p>			
<p>(8) how well bottom plugged _____</p>			
<p>DRILLERS REMARKS: <u>good well</u></p>			

C. B. P.


DEPT. OF NATURAL RESOURCES
BUREAU OF LAND & WATER RESOURCES

NOV 17 1982

RECEIVED

If well telescopes please sketch and show depths.

GROUND LEVEL

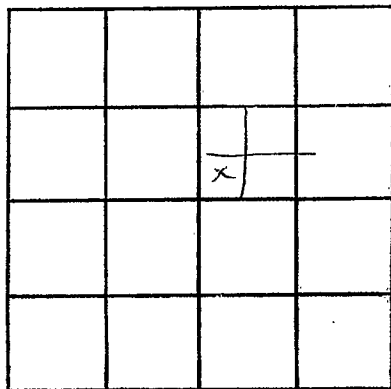

SECTION 27

Please indicate well location X.

ADDITIONAL INFORMATION

If more than one screen,
show locations of each on sketch.