

Marion
E
2031

MISSISSIPPI
 BOARD OF WATER COMMISSIONERS
 416 North State Street
 Jackson, Mississippi 39201

WATER WELL DRILLERS LOG

4-12 1982 F. J. Guadalupe, Inc. Marion
 date well completed firm name county well located

LANDOWNER:
Ernie Ackerman
RR 1, Teletown
 (mailing address)

description of formations encountered	from	to
<u>Red clay</u>	<u>0</u>	<u>20</u>
<u>Red sand</u>	<u>20</u>	<u>105</u>
<u>Coarse sand & gravel</u>	<u>105</u>	<u>115</u>

WELL LOCATION:
 sec. 31 T. 4 N R. 12 E
 S W
1 miles E of Darben
 (distance) (direction) (nearest town)

WELL PURPOSE: Home
 (home, irrigation, municipal, industrial)

- WELL COMPLETION DATA:
- (1) diameter (inches) 4
 - (2) total depth (feet) 115
 - (3) static water level (feet) 65 below above top of ground.
 - (4) casing PVC, 107,
 (material) (depth)
4 if telescope see back.
 (size)
 - (5) screen 8, 107,
 (length) (depth to top)
4, PVC
 (size) (material)
 - (6) pump 1/2, 10
 (HP) (yield gpm)
Electric
 (type power)
 - (7) electric log no
 (yes or no)
Electric
 (organization running log)
 - (8) how well bottom plugged Sand plug

DRILLERS REMARKS:


DEPT. OF NATURAL RESOURCES
 BUREAU OF LAND & WATER RESOURCES

MAY 25 1982

RECEIVED

If well telescopes please sketch and show depths.

GROUND LEVEL

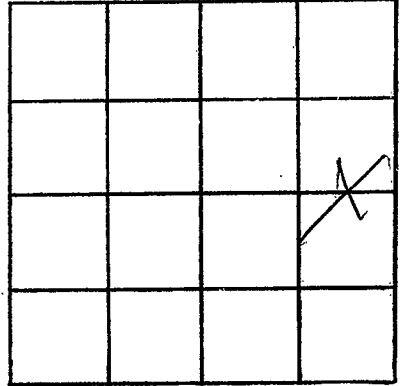

SECTION 31

Please indicate well location X.

ADDITIONAL INFORMATION

If more than one screen, show locations of each on sketch.